




2017

DATE

# TOWN OF LEXINGTON — BOARD OF PUBLIC WORKS

## WATER DIVISION

Sketch of Service Here

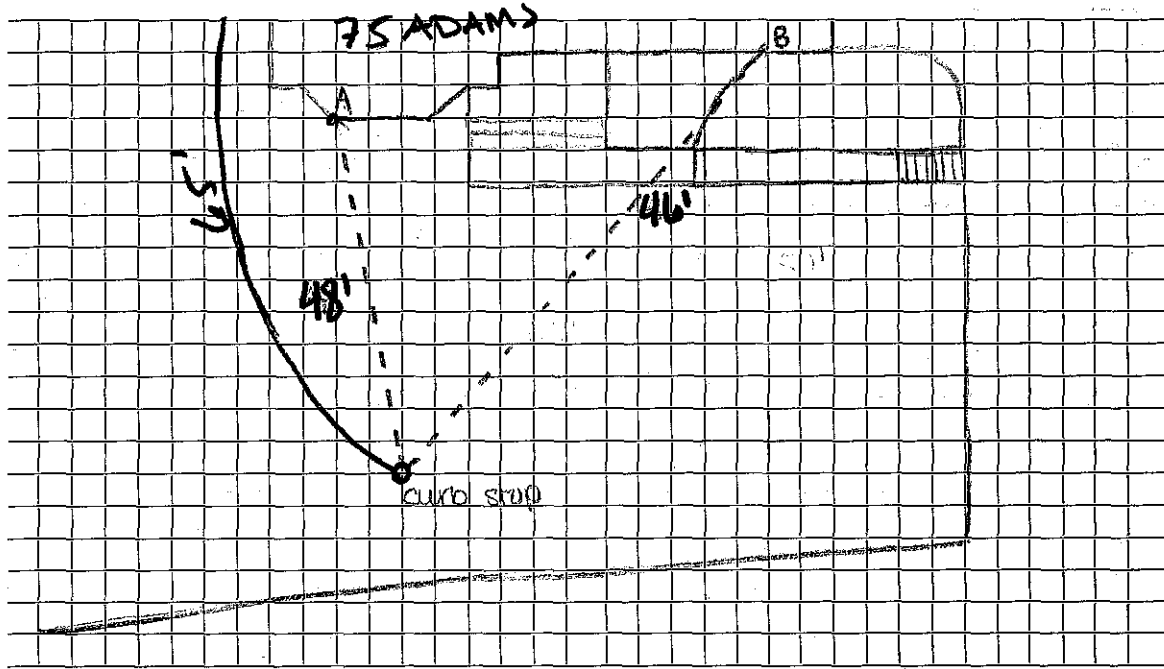

Connection made in Adams Street. Work completed .....

Remarks: .....

.....

.....