

WATER SERVICE RECORD

Name Carl F. Lannquist

Service No. 77

Address 76 Adams Street

Location

~~Repair~~ ~~Renewal~~ - New Service

*Comm. 5-9-55*


Date	Material	Amount	Total	Date	Amount
3/31/55	Labor	3 85		3-28-55 Deposited	60 00
	10% overhead	39	4 24	5-9-55 Refunded	8 63
	43' - 3/4" copper tubing @ .3693	15 88		NON CHARGE	51 37
	1 - 3/4" C x 1/2 I.W.H. stop waste	1 00		3/31/55 Labor	3 85
	3 hrs. Littlefield shovel @ 7.50	22 50		8' - 3/4" copper tubing @ .3693	2 95
	1 hr. trucking		75	1 - 3/4" C. corp-cock	4 33
	patching 4 x 3		4 00	1 - 3/4" C. curb-cock	4 67
			51 37	1 box and rod	3 90
				1 - 1/2 offset tail piece	50
				1 - 1/2 straight tail piece	50
				1/3 hrs. Littlefield shovel @ 7.50	2 50
				1 hr. trucking	75
					23 25

DATE \_\_\_\_\_

TOWN OF LEXINGTON — BOARD OF PUBLIC WORKS

**WATER DIVISION**

Sketch of Service Here

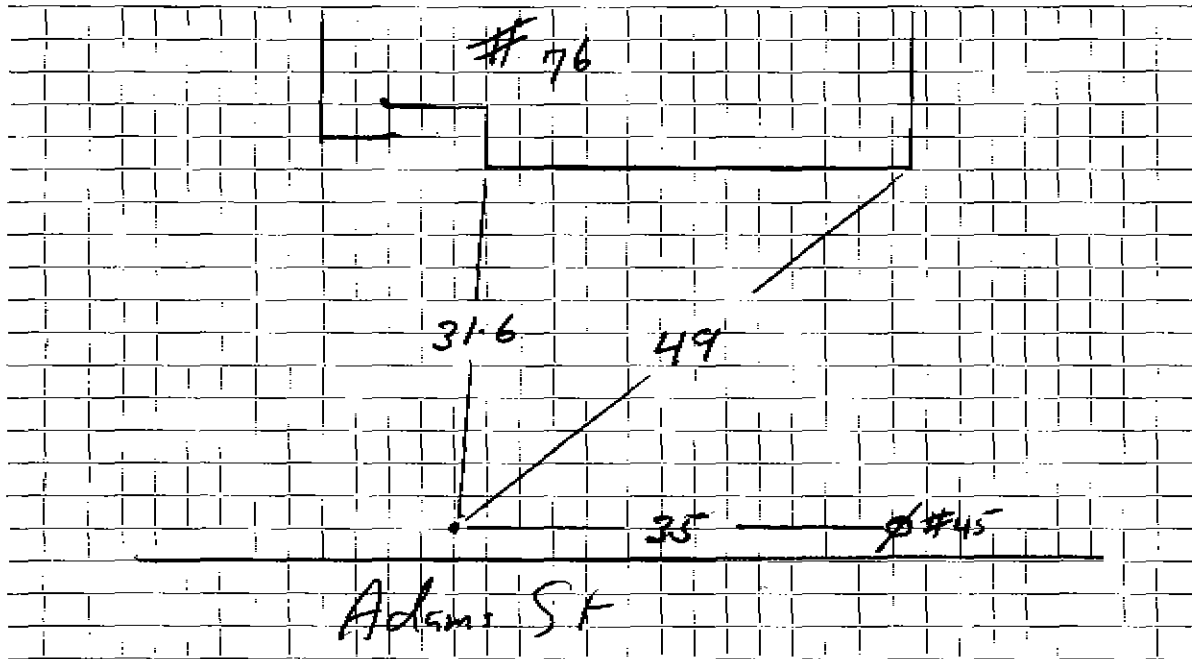

Connection made in ..... Street. Work completed .....

Remarks: .....

.....

.....