

Name Adolph Cronstron
 Address 79 Adams Street
 Lexington, Mass.

Service No. 153

Location 79 Adams Street

Kind of Pipe

Size

Size of Main

~~Repair - Renewal~~ - New Service

Location

Date	Material	Amount	Total	Date	Amount
Aug. 31, '48	Labor	6 30	6 30	Aug 13 '48	Deposited
	10% Overhead		63		
	39' 3/4" Copper Tubing		9 95		Non-Charge
	1-3/4" Cx 1/2" I.W.H. S & W 3		3 15	Aug. 25, '48	Labor
	1-3/4" c x 3/4" G. Union (3 pts)		1 32	31	Labor
	2 hrs. Littlefield Shovel		14 00	23'-3/4" Copper Tubing	5 87
	1 hr. Trucking		75	1-3/4" C. Corp. Cock	3 00
	Patching 15 x 3		15 00	1-3/4" C x 3/4" C. Cirb Cock	3 68
			51 10	1-Box & Rod	3 55
				3 hrs. Littlefield Shovel	21 00
				1-1/2" Offset Tail Piece	30
				1-1/2" Straight Tail Piece	30
				1 hr. Trucking	75
					56 18

Hadley Press, Inc., Lexington

Com. 10/25/48

Laber

DATE _____

TOWN OF LEXINGTON—BOARD OF PUBLIC WORKS

WATER DIVISION

The undersigned applies for a supply of water at No. _____ St. and hereby agrees to comply with the rules and regulations as now, or at any future time, established by the Board of Selectmen.

Am't. of Estimate \$ _____


Owner _____

Am't. Paid \$ _____

Address _____

Builder _____

Sketch of Service Here

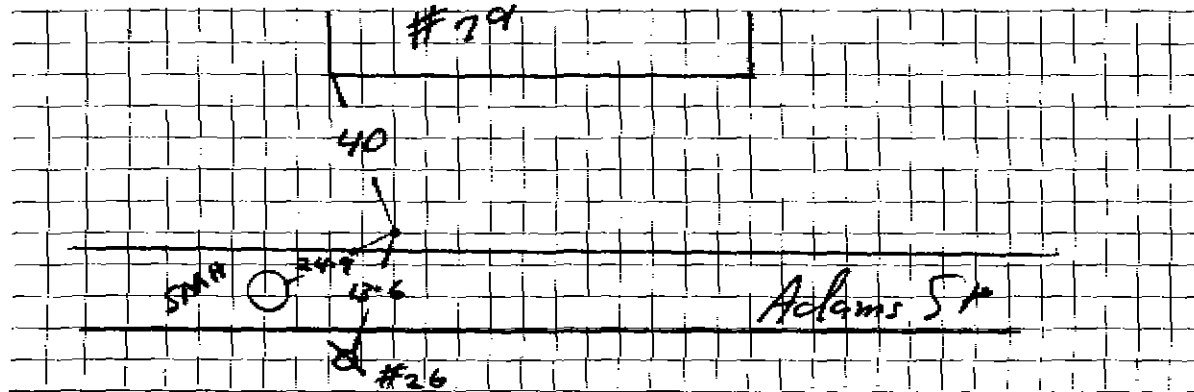

Connection made in _____ Street. Work completed _____ 19

Remarks: