

## WATER SERVICE RECORD

# 6111

Name William Ryan

Service No. 56

Address ~~XXXXXXXXXXXXXXXX~~ 8 Adams Street

Location

Repair ~~XXXXXXXXXX~~ Renewal ~~XXXXXXXXXX~~ - New Service

Chart 75-60


Date	Material	Amount	Total	Date	Amount	
5-14-60	Labor	2.21		4-29-60	Deposit	100 50
	10% O.H.	.22	2 43	7-5-60	Retard	<del>24 15</del>
	140' 1" Copper tubing @.4676		65 46			25 85
	2 1" 3 Part Copper Union @3.98		7 96			
			75 85		NON CHARGE	
					Labor	1 77
				7'	1" Copper tubing @.4676	3 27
				1	1" C Corp Cock	7 31
				1	1" C Curb Cock	8 06
				1	Box & Rd	5 00
						25 41

DATE \_\_\_\_\_

TOWN OF LEXINGTON — BOARD OF PUBLIC WORKS  
WATER DIVISION

Sketch of Service Here

FRONT OF 6022 SAFF JALOMS

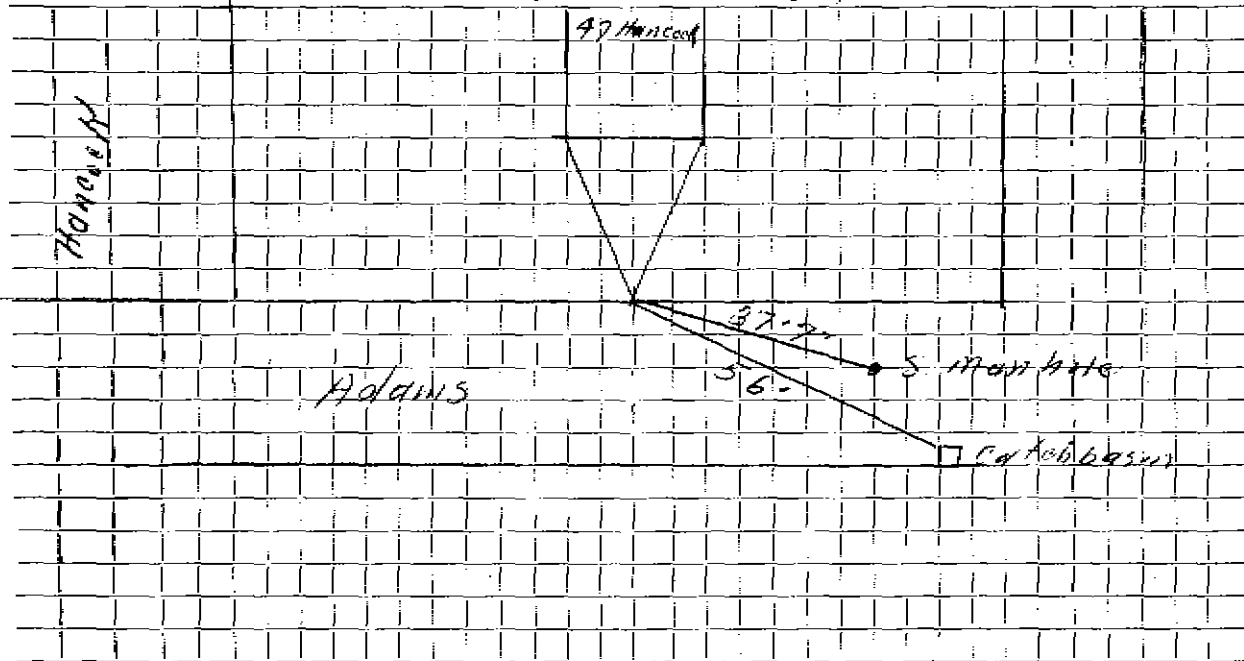

Connection made in ..... Street. Work completed .....

Remarks: .....

.....

.....