

WATER SERVICE RECORD

Name Custom Colonials, Inc.

Service No. 92 #1002

Address 80 Adams Street

Location

Repair—Renewal—New Service

Comm. 9/30/57


Date	Material	Amount	Total	Date	Amount
5/25/57	Labor	2 15		5-16-57	Deposit \$ 50 00
	10% overhead	22	2 37	9-30-57	Refund \$ 23 74
	43' - 3/4" Copper tubing @ .4228	18 18			NON CHARGE \$ 26 26
	1 - 3/4" Cx 1/2 I.W.H. Stop & Waste	4 96		Labor	2 15
	1 hr. Trucking		75	10' - 3/4" Copper tubing @ .4228	4 23
			26 26	1 - 3/4" C. Corp Cock	4 64
				1 - 3/4" C. Curb Cock	5 94
				1 Box & Rod	4 62
				1 - 1/2 Straight tailpiece	50
				1 - 1/2 Offset tailpiece	50
					22 58
				* \$9.05 applied to S.A.C. #64	

DATE _____

TOWN OF LEXINGTON — BOARD OF PUBLIC WORKS

WATER DIVISION

Sketch of Service Here

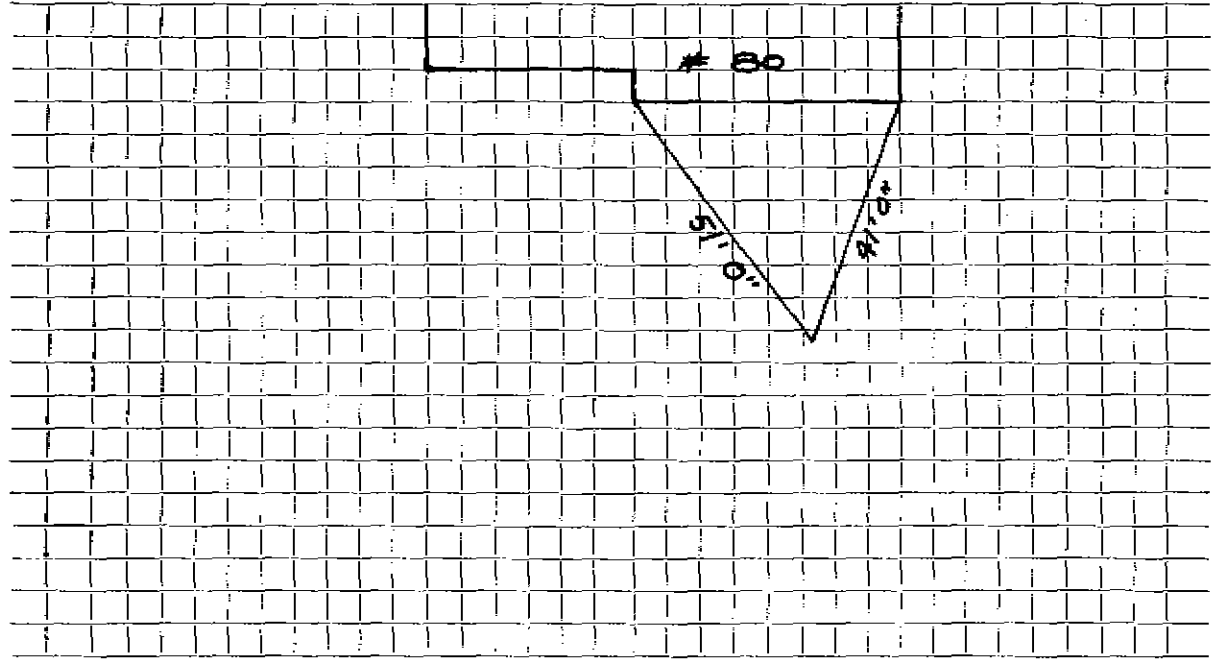

Connection made in Street. Work completed

Remarks:
.....
.....