

1254

Name Alvar Mellin
Address 81 Adams Street
Lexington, Mass.

Service No. 1

Location 81 Adams Street

Kind of Pipe Size Size of Main
~~Repair - Renewal~~ - New Service Con. 3-8-50 Location

Date	Material	Amount	Total	Date	Location	Amount
Jan. 18 '50	Labor	4 05		Jan. 3 '50	Deposited	65 00
	10% Overhead	41	4 46			2 75
	48'- 3/4" Copper Tubing @ .23		11 04			58 54
	1- 3/4" C x 1/2" I.W.H. S&W		3 29		Non-Charge	
	3 hrs. Littlefield Shovel		21 00	Jan. 18 '50	Labor	20 92
	1 hr. Trucking		75		30'- 3/4" Copper @ .23	6 90
	Patching 18 x 3		18 00		1- 3/4" C. Corp-cock	3 15
			58 54		1- 3/4" C. x 3/4" C. Curb-cock	3 85
					1 Box & Rod	3 70
					1- 2" Offset Tail Piece	38
					1- 1/2" Straight Tail Piece	38
					3 1/2 hrs. Littlefield	24 50
	Labor				1 hr. Trucking	75
						64 53

DATE _____

TOWN OF LEXINGTON - BOARD OF PUBLIC WORKS

WATER DIVISION

The undersigned applies for a supply of water at No. St. and hereby agrees to comply with the rules and regulations as now, or at any future time, established by the Board of Selectmen.

Am't of Estimate \$.....

Owner


Am't Paid \$.....

Address

Builder

.....

Sketch of Service Here

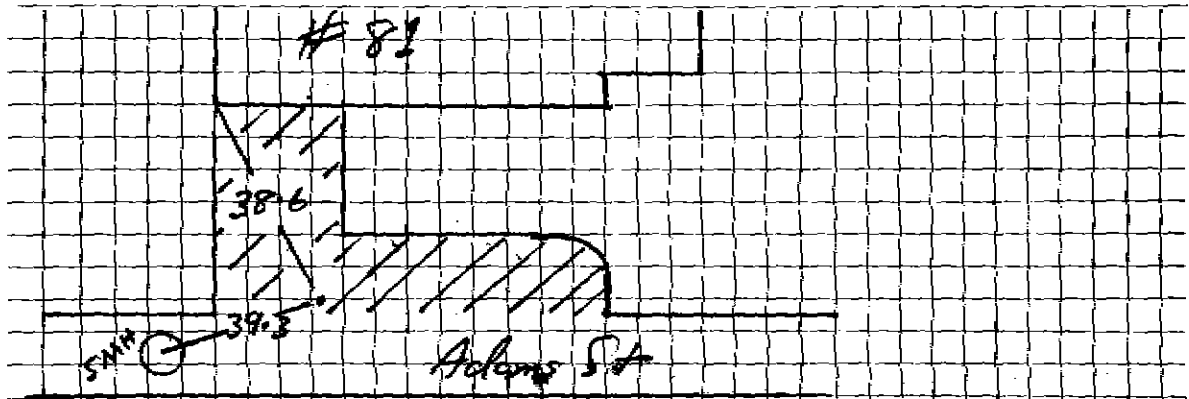

Connection made in Street.

Work completed19

Remarks: *curb in driveway*