

## WATER SERVICE RECORD

Name Custom Colonials, Inc.

Service No. 103

Address 82 Adams Street

Location

~~Repair—Renewal—New Service~~

Comm. 9/30/57


Date	Material	Amount	Total	Date	Amount	
6/3/57	Labor	2 04		5-27-57	Deposit	\$ 50 00
	10% overhead	20	2 24	9-30-57	Refund	\$ 25 98
	38' - 3/4" Copper tubing @ .4228	16 07			NON CHARGE	\$ 24 02
	1 - 3/4" Cx 1/2 I.W.H. Stop & Waste		4 96	6/3/57	Labor	1 76
	1 hr. Trucking		75	12' - 3/4" Copper tubing @ .4228		5 07
			24 02	1 - 3/4" C. Corp Cock		4 64
				1 - 3/4" C. Curb Cock		5 94
				1 Box & Rod		4 62
				1 - 1/8" Straight tailpiece		50
				1 - 1/8" Offset tailpiece		50
						23 03

DATE \_\_\_\_\_

TOWN OF LEXINGTON — BOARD OF PUBLIC WORKS

WATER DIVISION

Sketch of Service Here

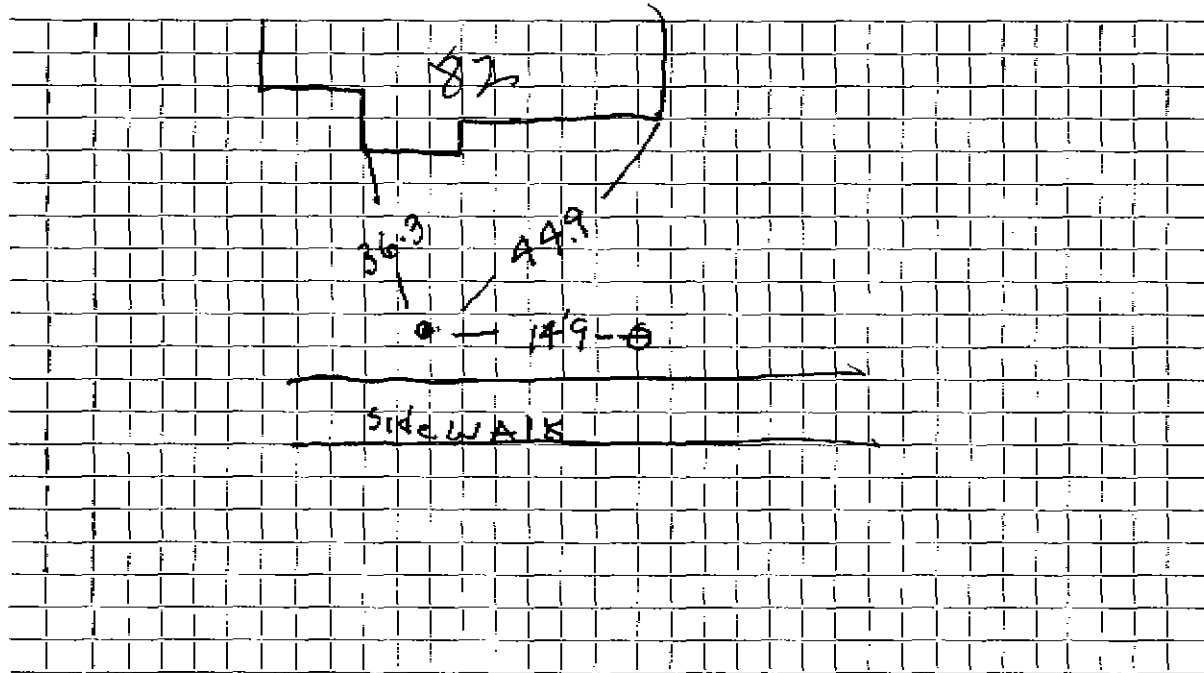

Connection made in ..... Street. Work completed .....

Remarks: 1- 3/4 3 part union 2 1/2 feet From Cor. p. ....