

WATER SERVICE RECORD

Name Stanley Kunicki

Service No.

# 2486

Address 83 Adams Street

154

Location Lexington, Mass.

Repair - ~~Renewal~~ - New Service


7-24-51

Date	Material	Amount	Total	Date	Amount
8-9-51	Labor	5 30	5 30	7-11-51	Deposited 100 00
	10% Overhead		53	9-24-51	Refunded (15 75)
	105'-3/4" Copper Tubing @ .326	34 23			84 25
	1- 3/4" C x 1/2 I.W.H. S&W	4 00			No Charge
	2- 3/4" C x 3/4" C Unions (3 pts)	3 44		8-9-51	Labor 7 58
	3 Hrs. Littlefield Shovel @ 7.00	21 00		26'- 3/4" Copper Tubing @ .326	8 48
	1 Hr. Trucking @ .75	75		1- 3/4" C. Corp Cock	4 33
	Patching 15x3		15 00	1- 3/4" C 3/4" C Curb-Cock	4 67
			84 25	1-Box & Rdd	4 68
				1-1/2 offset Tail Piece	50
				1-1/2 Straight Tail Piece	50
				2 Hrs. Littlefield Shovel @ 7.00	14 00
				1 Hr. Trucking @ .75	75
					45 49

DATE \_\_\_\_\_

TOWN OF LEXINGTON — BOARD OF PUBLIC WORKS  
WATER DIVISION

Sketch of Service Here

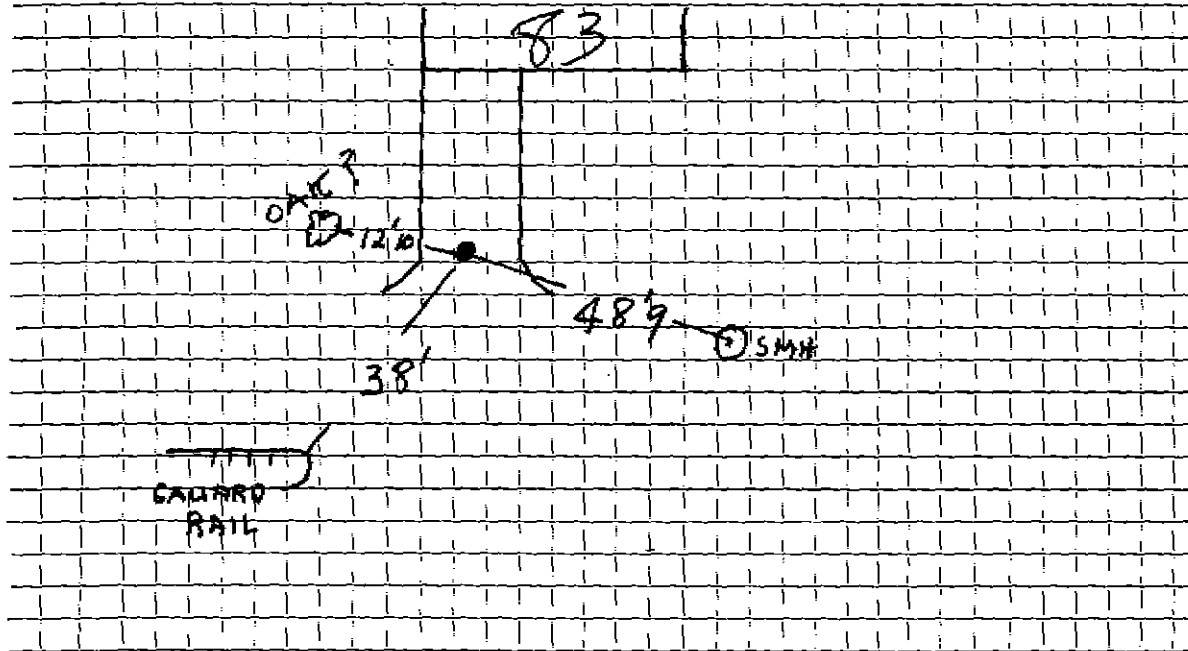

Connection made in ..... Street. Work completed .....

Remarks: .....

.....

.....