

Name John E. Anderson
 Address 87 Adams Street
 Lexington, Mass.

Service No.

Kind of Pipe

Location

Size

Size of Main

~~Repair~~ ~~Renewal~~ New Service.

Location

Date	Material	Amount	Total	Date	Amount
Oct. 14, '48	Labor	3 35	3 35	Oct 6. 48	60 00
" 15 "	"	4 80	4 80	Presented	
	10% Overhead		82	Non-Charge	53 57
	40'-3/4" Copper Tubing @ .255		10 20	Oct. 14, '48 Labor	7 68
	1-3/4" C x 1/2" I.W.H S&W		3 15	37'-3/4" Copper Tubing @ .255	9 44
	1 1/2 hrs. Littlefield Shovel		10 50	1-3/4" C. Corp-cock	3 00
	1 hr. Trucking		75	1-3/4" C x 3/4" C. Curb-cock	3 68
	Patching 20 x 3		20 00	1-Box & Rod	3 55
DEC 8 98	Permit-Increase to 1" Copper NOT Insp. by w/s Dept.		53 57	1 1/2 hrs. Littlefield Shovel	10 50
	Labor			1-1/2" Offset Tail Piece	30
				1-1/2" Straight Tail Piece	30
				1 hr. Trucking	75
					39 20

Hadley Press, Inc., Lexington

DATE _____

TOWN OF LEXINGTON—BOARD OF PUBLIC WORKS

WATER DIVISION

The undersigned applies for a supply of water at No. _____ St. and hereby agrees to comply with the rules and regulations as now, or at any future time, established by the Board of Selectmen.

Am't. of Estimate \$ _____


Owner _____

Am't. Paid \$ _____

Address _____

Builder _____

Sketch of Service Here

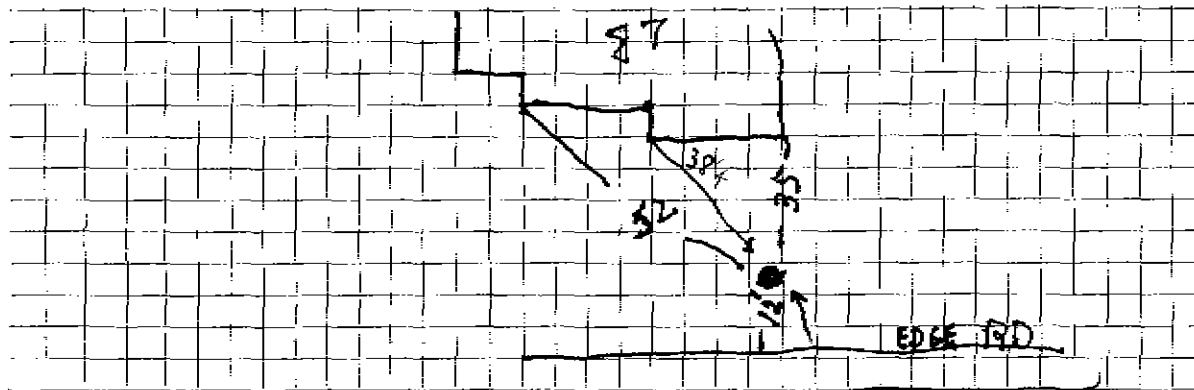

Connection made in _____

Street.

Work completed _____

19

Remarks: