

Name George J. Bacigalupo

Service No. 107

Address 89 Adams Street

#4603 #7360

Lexington

Location 89 Adams Street

Kind of Pipe

Size

Size of Main

~~Repair~~ ~~Renewal~~ ~~New Service~~

Com. 9-5-50

Location

Date	Material	Amount	Total	Date	Amount	
June 28 '50	Labor	5 00		<i>May 23 '50</i> <i>Deputed</i>	68 00	
	10% Overhead	50	5 50		7 50	
	47' - 3/4" Copper Tubing @ 23¢		10 81		57 35	
	1 - 3/4" C x 1/2" I.W.H. S&W		3 29			
	2 hrs. Littlefield Shovel		14 00	June 28 '50	Labor	8 25
	1 hr. Trucking		75	23' - 3/4" Copper Tubing @ 23¢	5 29	
	Patching 23 x 3		23 00	1 - 3/4" C. Corp-cock	3 15	
			57 35	1 - 3/4" C X 3/4" C. Curb-cock	3 85	
				1 Box & Rod	3 35	
				1 - 1/2" Offset Tail Piece	38	
				1 - 1/2" Straight Tail Piece	38	
				3 hrs. Littlefield Shovel	21 00	
	Labor			1 hr. Trucking	75	
					46 40	

DATE _____

TOWN OF LEXINGTON - BOARD OF PUBLIC WORKS
WATER DIVISION

The undersigned applies for a supply of water at No. St. and hereby agrees to comply with the rules and regulations as now, or at any future time, established by the Board of Selectmen.

Am't of Estimate \$.....

Owner


Am't Paid \$.....

Address

Builder

.....

Sketch of Service Here

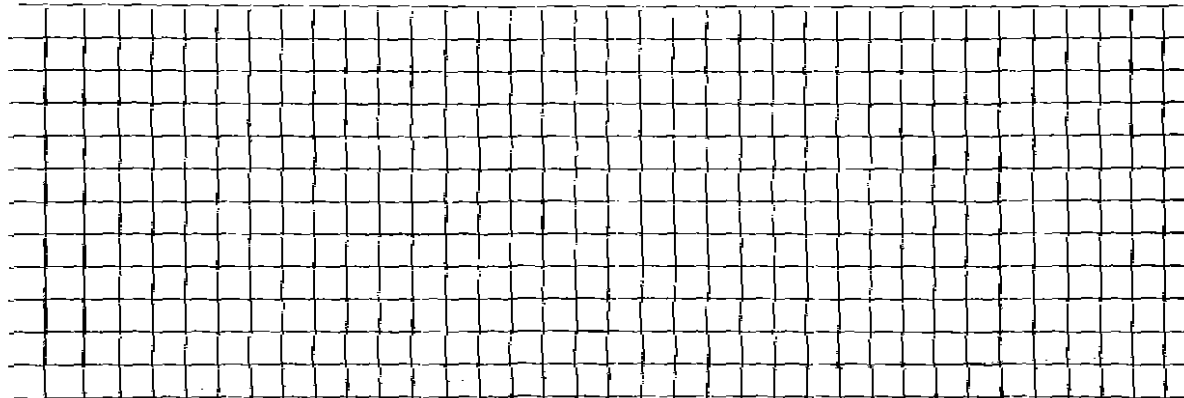

Connection made in Street.

Work completed19

Remarks: