

Name Calvin Belbin  
 Address 91 Adams Street  
 Lexington, Mass.

Service No. 13

# 2459

Location 91 Adams Street

Kind of Pipe Size Size of Main  
~~Repair~~ ~~Renewal~~ - New Service Com. 2-21-49 Location

Date	Material	Amount	Total	Date	Amount
Jan. 17, '49	Labor	4 30	4 30	Jan. 11, '49	75 00
	10% Overhead		43	<i>Deposited</i>	<i>1 23</i>
	40' - 3/4" Copper Tubing @.27	10 80		<i>Balance Forward</i>	<u>86 23</u>
	1 - 3/4" C x 1/2" I.W.H. S&W	3 15		Non-Charge	
	1 - 3/4" C x 3/4" C Union (5 pt)	1 32		Jan. 17, '49 Labor	1 15
	Littlefield Shovel 3 hrs. @7.00	21 00		23' - 3/4" Copper Tubing @.27	6 21
	Trucking 1 hr.		75	1 - 3/4" C Corp-cock	3 00
	Patching 15 x 3		15 00	1 - 3/4" C Curb-cock	3 68
			56 75	1 - Box & Rod	3 55
				1 - 1/2" Offset Tail Piece	30
				1 - 3/4" Straight Tail Piece	30
				Littlefield Shovel 1 hr. @7.00	7 00
				Trucking	75
	Labor				<u>25 94</u>

TOWN OF LEXINGTON - BOARD OF PUBLIC WORKS

**WATER DIVISION**

The undersigned applies for a supply of water at No..... St. and hereby agrees to comply with the rules and regulations as now, or at any future time, established by the Board of Selectmen.

Am't of Estimate \$.....

Owner .....


Am't Paid \$.....

Address .....

Builder .....

.....

Sketch of Service Here

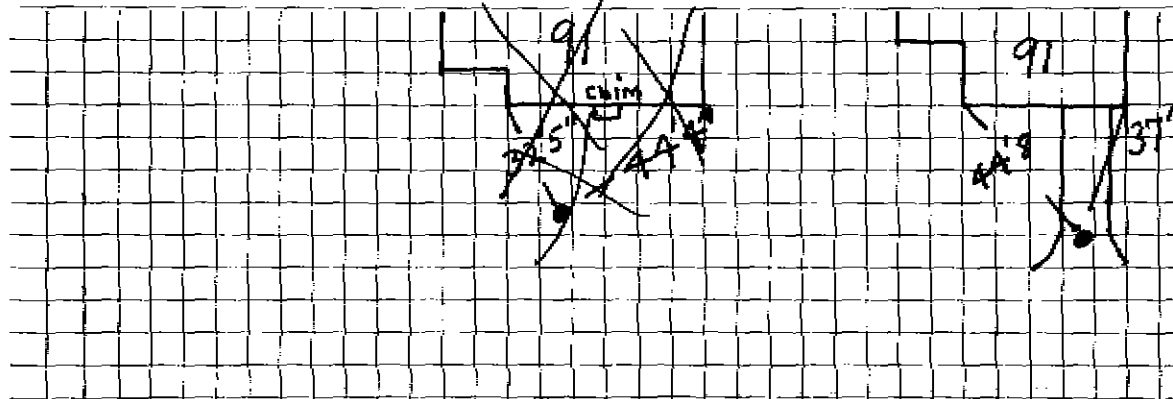

Connection made in ..... Street.

Work completed .....19

Remarks: