

WATER SERVICE RECORD

Name Moore Const. Co.

Service No. 28

Address 94 Adams St.

Location

Repair—Renewal—New Service Kirkland #2099

DEC 18 1972


Date	Material	Amount	Total	Date	Amount
7/11/72	275' 3/4" Copper tubing			1-8-72	100 05
6/19/72	Labor	17 92		12-11-72	58 76
	10% O.H.	1 79	19 71		71 34
16'	1" Copper pipe .99		15 84		
1	1" Corporation		10 66		
1	1" Curb stop		14 43		
	Box & Rod		7 60		
1	Hr. Truck		3 00		
			<u>71 24</u>		

DATE _____

TOWN OF LEXINGTON -- BOARD OF PUBLIC WORKS

WATER DIVISION

Sketch of Service Here

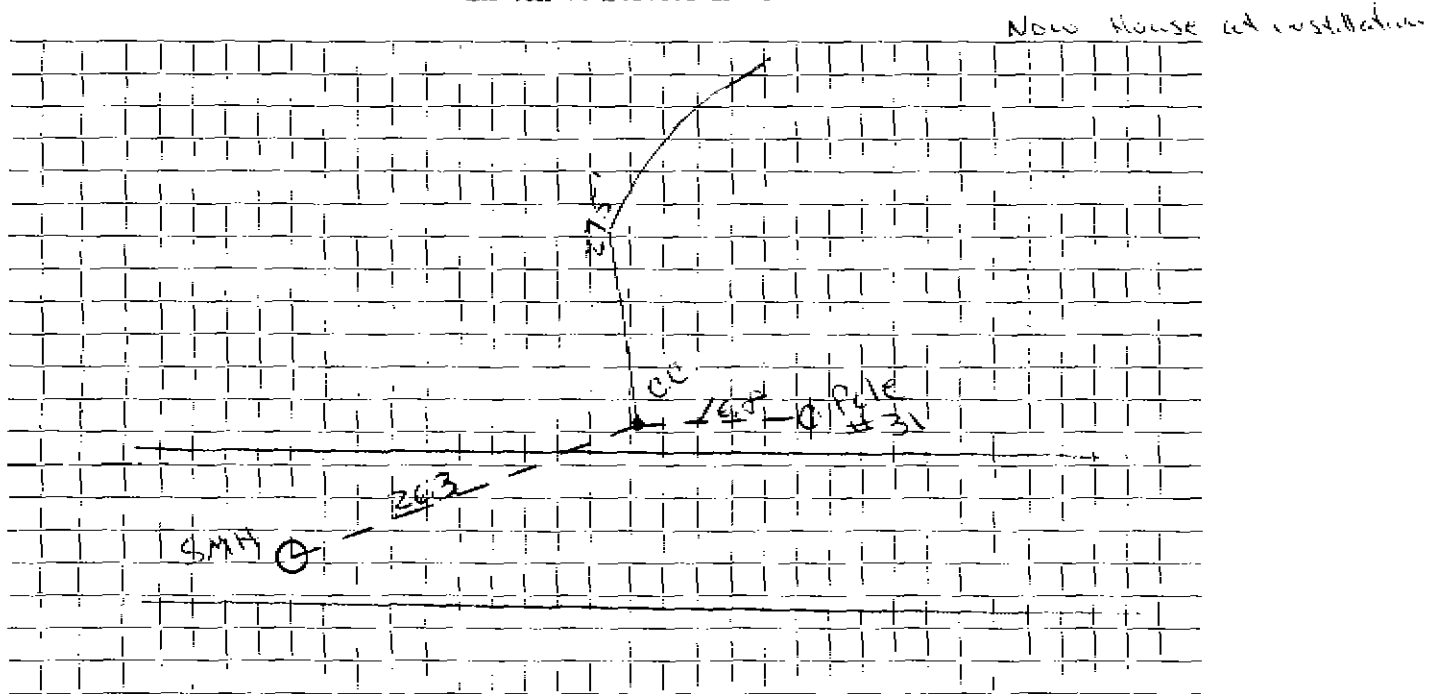

Connection made in Street. Work completed

Remarks:

.....

.....