

**WATER SERVICE RECORD**

Name Mark Moore Homes

Service No. \_\_\_\_\_

Address # 917 ADAMS ST.

Location \_\_\_\_\_

Repair—Renewal—New Service


McLaughlin #0201

Date	Material	Amount	Total	Date		Amount
8/21 92	c/c # BOX 110' of 1" COPPER					
					OUTSIDE	
				9/27/57 24"	3/4" Copper @ .375	
				1	3/4" C Corp Cock	
				1	3/4" C Curb Cock	

DATE 8/21/92

TOWN OF LEXINGTON — BOARD OF PUBLIC WORKS

WATER DIVISION

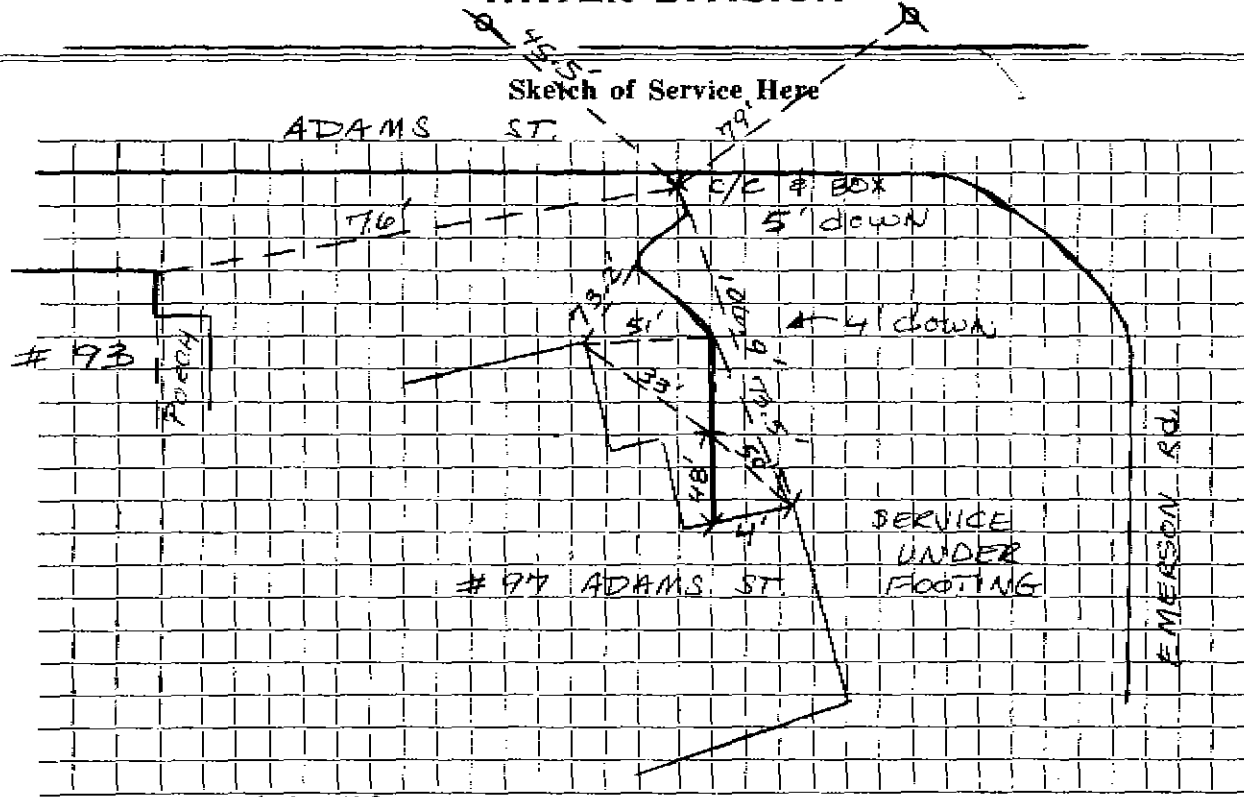

Connection made in ADAMS ST. Street. Work completed .....

Remarks: ... CONTR: J. McLAUGHLIN .....