

WATER SERVICE RECORD

Name _____

Service No.

Address

1. Final Art

Location

Repair—Renewal—New Service


LOT 25

DATE _____

TOWN OF LEXINGTON — BOARD OF PUBLIC WORKS

WATER DIVISION

Sketch of Service Here

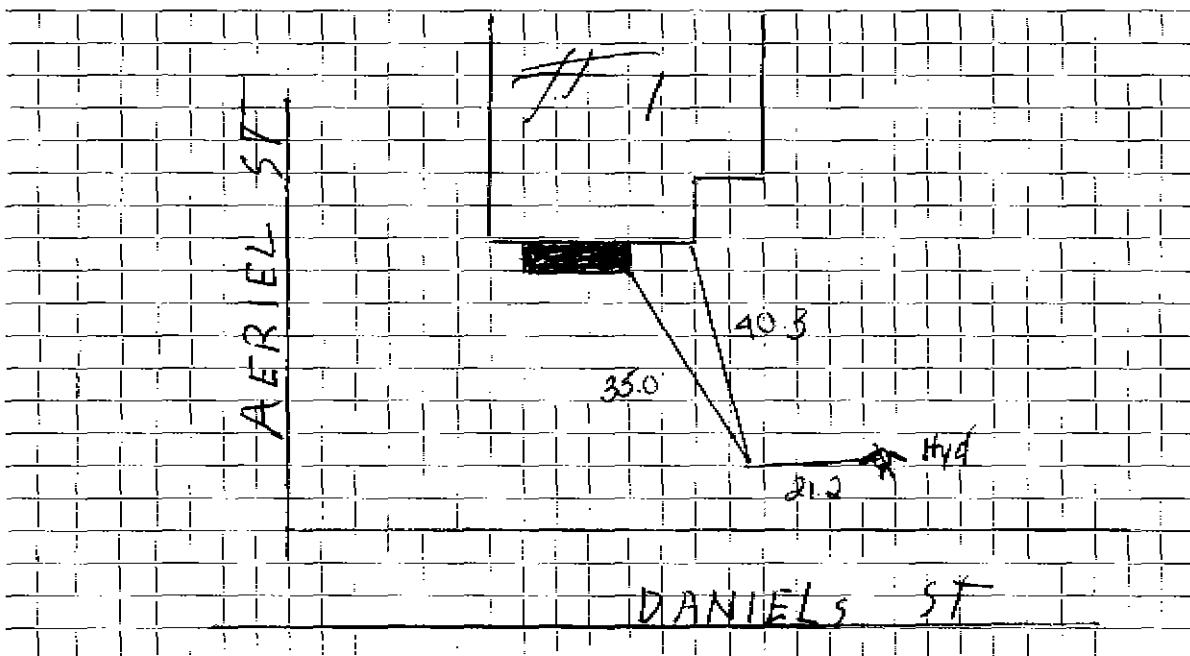

Connection made in Street. Work completed

Remarks: