

Name Waverley Construction Co.

Service No.

98 3198
3035

Address 11 Aerial Street

Lexington, Mass.

Location 11 Aerial Street

Kind of Pipe

Size

Size of Main

~~Repair - Rework~~ - New Service

Com. 12-16-46

Location

Date	Material	Amount	Total	Date	Amount
Nov. 14, '46	Labor	1 10	1 10	Oct 22 '46	15 00
	10% Overhead		11	Nov 17 '46	2 50
	34' - 3/4" Copper Tubing @ .24	8 16	8 16		12 75
	1 - 3/8" C x 1/2" I.W.H. S & W	2 82	2 82	Nov. 14, '46	2 20
	Trucking 1 hr. @ .75	75	75	16' - 3/4" Copper Tubing @ .24	3 84
	<u>Trench Dug By Owner</u>		12 94	1 - 3/4" C Corp-cock	2 70
				1 - 3/8" C x 3/4" C Curb-cock	3 30
				1 - Box & Rod	3 50
				1 - 1/2" Offset Tail Piece	50
				1 - 1/2" Straight Tail Piece	50
				Trucking 1 hr. @ .75	75
					17 29
	Labor				

Supported
12 75
No-Charge

Hadley Press, Inc., Lexington

DATE _____

TOWN OF LEXINGTON—BOARD OF PUBLIC WORKS

WATER DIVISION

The undersigned applies for a supply of water at No. _____ St. and hereby agrees to comply with the rules and regulations as now, or at any future time, established by the Board of Selectmen.

Am't. of Estimate \$ _____


Owner _____

Am't. Paid \$ _____

Address _____

Builder _____

Sketch of Service Here

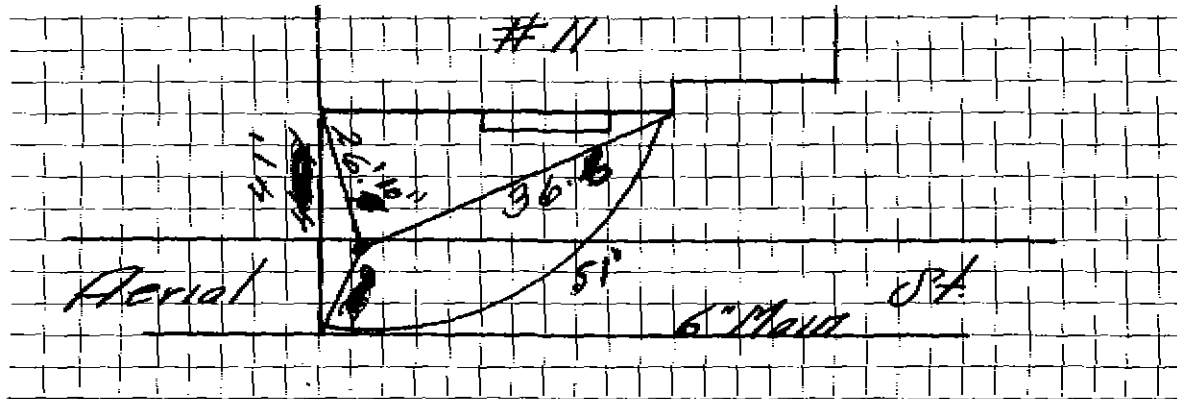

Connection made in _____ Street.

Work completed _____ 19

Remarks: