

Name Waverley Const. Co.

Address 12 Aerial Street

Lexington, Mass.

Location 12 Aerial Street

2256 Service No. 97 3177
#3844

Kind of Pipe

Size

Size of Main

~~Repair~~ ~~Renewal~~ — New Service

Com. 12-16-46

Location

Date	Material	Amount	Total	Date	Location	Amount
Oct. 28, '46	Labor	95	95	Oct 22 46	Deposited	15 00
	10% Overhead		09	Oct 19 46	Non-Charge	2 28
	29' - $\frac{3}{4}$ " Copper Tubing @.23	6 67				11 28
	1 - $\frac{3}{4}$ " C x $\frac{1}{2}$ " I.W.H. Stop & Waste	2 82		Oct. 28, '46	Labor	95
	Trucking 1 hr. @.75		10 53		26' - $\frac{3}{4}$ " Copper Tubing @.23	5 98
	<u>Trench Dug By Owner</u>		75		1 - $\frac{3}{4}$ " C Corp-cock	2 70
			11 28		1 - $\frac{3}{4}$ " C x $\frac{3}{4}$ " C Curb-cock	3 30
					1 - Box & Rod	3 30
					1 - $\frac{1}{2}$ " Straight Tail Piece	50
					1 - $\frac{1}{2}$ " Offset Tail Piece	50
					Trucking 1 hr. @.75	75
						17 98
	Labor					

Hadley Press, Inc., Lexington

DATE _____

TOWN OF LEXINGTON - BOARD OF PUBLIC WORKS

WATER DIVISION

The undersigned applies for a supply of water at No. _____ St. and hereby agrees to comply with the rules and regulations as now, or at any future time, established by the Board of Selectmen.

Am't. of Estimate \$ _____


Owner _____

Am't. Paid \$ _____

Address _____

Builder _____

Sketch of Service Here

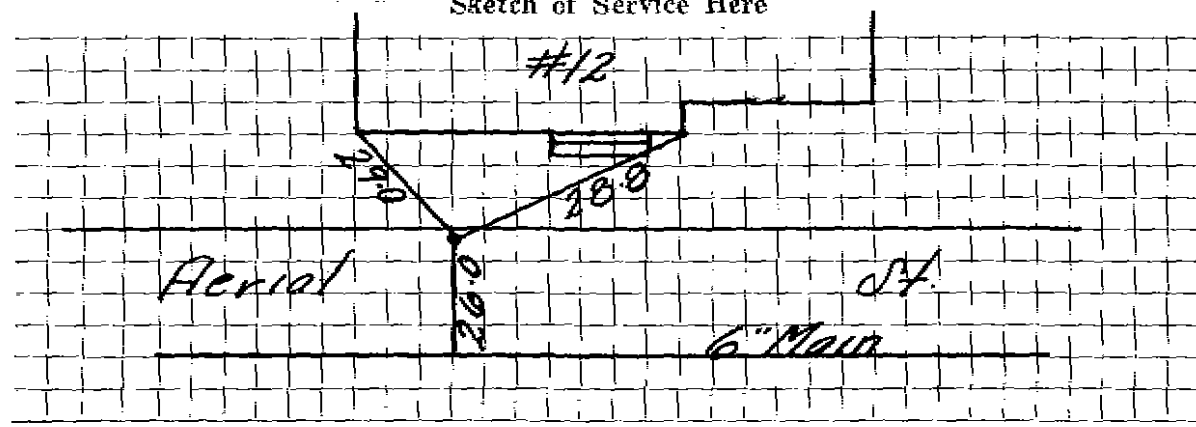

Connection made in _____ Street.

Work completed _____ 19

Remarks: