

Name Robert Cataldo

Service No.

3871

Address 14 Aerial Street

Location 14 Aerial Street

Kind of Pipe

Size

Size of Main

~~Repair~~ ~~Alter~~ ~~Extend~~ - New Service

Jan 19 47

Location

Date	Material	Amount	Total	Date	Amount
Oct. 13, '47	Labor	1 10	1 10	<i>Oct 16 47</i>	<i>Deposited</i>
	10% Overhead		11	<i>Dec 4 47</i>	<i>Refunded</i>
	33' - 3/4" Copper Tubing @.26	8 58	8 58		<i>Non-Charge</i>
	1 - 3/4" C x 1/2" I.W.H. S & W	3 15	3 15	Oct. 13, '47	Labor
	Trucking 1 hr. @.75		75		1 10
			<u>18 69</u>	24' - 3/4" Copper Tubing @.26	6 24
				1 - 3/4" C Corp-cock	3 00
				1 - 3/4" C x 3/4" C Curb-cock	3 68
				1 - Box & Rod	4 26
				1 - 1/2" Straight Tail Piece	30
				1 - 1/2" Offset Tail Piece	30
				Trucking 1 hr. @ .75	75
					<u>19 63</u>
	Labor				

TOWN OF LEXINGTON - BOARD OF PUBLIC WORKS

WATER DIVISION

The undersigned applies for a supply of water at No. St. and hereby agrees to comply with the rules and regulations as now, or at any future time, established by the Board of Selectmen.

Am't of Estimate \$.....


Owner

Am't Paid \$.....

Address

Builder

Sketch of Service Here

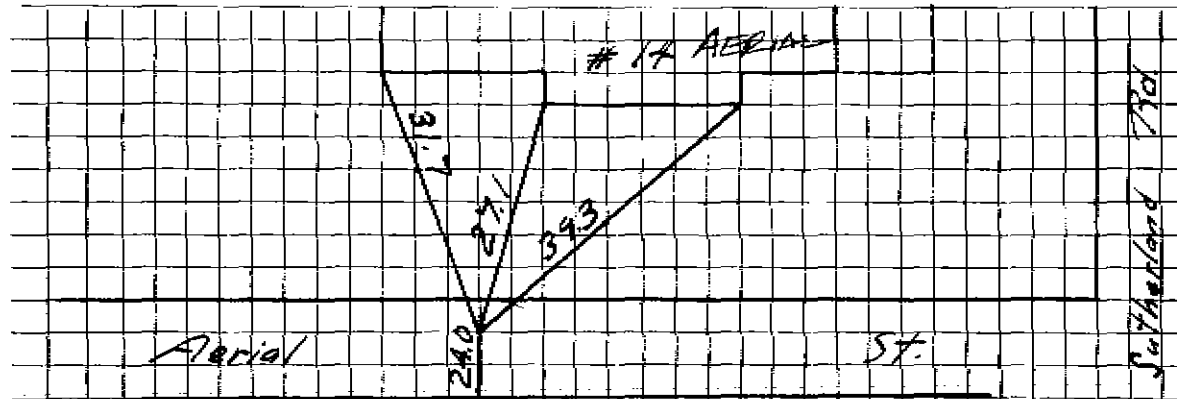

Connection made in Street.

Work completed19

Remarks: