

Name Eric Sahlberg
 Address 7 Frost Street, Cambridge
 #2 Aerial St.

Service No. ~~47~~ 25
 # 5541

Location Lot 17 Aerial Street

Kind of Pipe Size Size of Main

~~Repair - Renewal - New Service~~ Location

Date	Material	Amount	Total	Date	Amount
1938					
July 27	2 hrs. @ 60¢		1 20	August 9, 1938	Deposited
Course 8-16-38	40' 3/4" Copper Tubing @ 20¢		8 00		
	1 3/4" S. & W.		3 75		
	2 hrs. trucking @ 75¢		1 50		
	1 3/4" C. Union (3 parts)		1 25		
			15 70		
	Flat Rate:				
	40' @ 50¢		\$20 00.		
	Labor				

Hadley Press, Inc., Lexington

DATE July 9-37

TOWN OF LEXINGTON—BOARD OF PUBLIC WORKS
WATER DIVISION

The undersigned applies for a supply of water at No. Lot 17 Daniel St. and hereby agrees to comply with the rules and regulations as now, or at any future time, established by the Board of Selectmen.

Am't. of Estimate \$ _____

Owner Nancy E. Johnson


Am't. Paid \$ _____

Address 50 Brighton St

Builder _____

Belmont
by Eric S. Leung

Sketch of Service Here

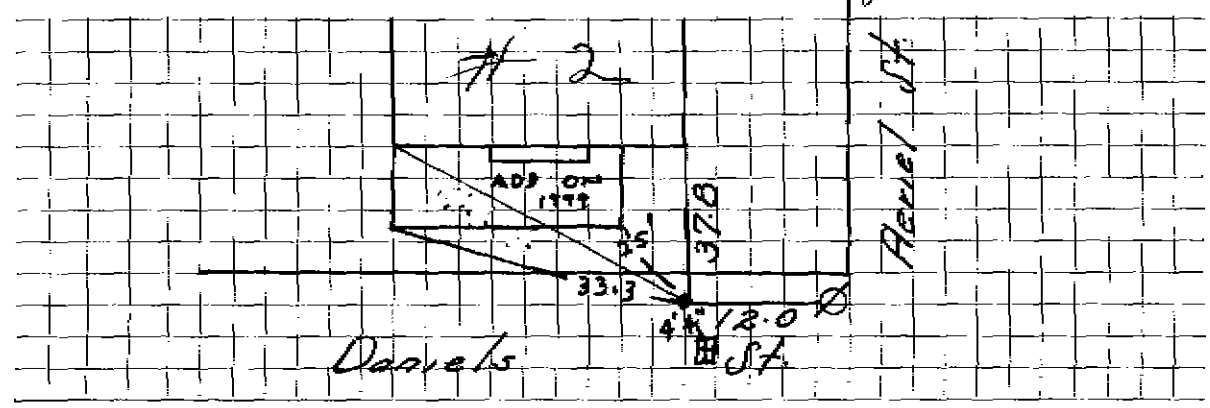

Connection made in _____ Street. Work completed _____ 19

Remarks: