

Name

~~Harry Johnson~~

Shackron James Gaudet

Service No.

~~30~~ 26

Address

~~50 Brighton Street~~ 11 ~~Endicott Ave~~ Somerville
#4 Aerial St.
Belmont, Mass.

Location Lot 18 Aerial Street

Kind of Pipe

Size

Size of Main

~~Repair-Rewak~~ - New Service

Location

Date	Material	Amount	Total	Date	Amount
1938					
Aug. 5,	2 hrs. @ 60¢		1 20	June 16 1938	18 00
Course	38' 3/4" C. Tubing @ 20¢		7 60	Deposited	
File 28	1 3/4" S. & W.		3 75		
	2 hrs. Trucking @ 75¢		1 50		
			<u>14 05</u>		
	Flat Rate:				
	\$18.00				
	Labor				

Howley Press, Inc., Lexington

DATE July 9-37

TOWN OF LEXINGTON - BOARD OF PUBLIC WORKS

WATER DIVISION

The undersigned applies for a supply of water at No. 48 Acad St. and hereby agrees to comply with the rules and regulations as now, or at any future time, established by the Board of Selectmen.

Am't. of Estimate \$ _____

Owner

Harry B Johnson

Am't. Paid \$ _____


Address

50 Brighton St

Builder _____

Belmont
By Eric of Sahlberg

Sketch of Service Here

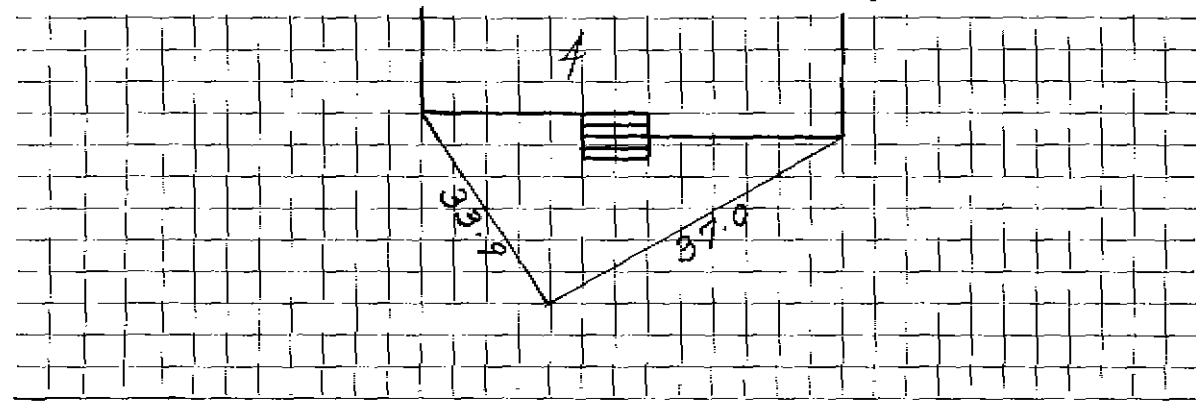

Connection made in _____ Street.

Work completed _____ 19

Remarks: