

Name C. D. Richardson

Service No. ~~26~~ 27

Address 86 Alexander Ave., Belmont,
#5 Aerial St.

3364

Location #5 Aerial St., (Lot #24)

Kind of Pipe

Size

Size of Main

Repair—Renewal—New Service

Location

Date
1938

Material

Amount

Total

Date

Amount

6/18/38

2 hrs. @ 60¢

1 20

June 6, 1938 Deposited

18 00

36' 3/4" C. Tubing @ 20¢

7 20

1 3/4" Bushing

30

1 3/4" s. & W.

3 75

Trucking - 2 hrs @ 75¢

1 50

13 95

Flat Rate

36' @ 50¢

\$18 00

Labor

36'
50
18.⁰⁰
(804 5 31 38)

DATE June 6, 1938

TOWN OF LEXINGTON—BOARD OF PUBLIC WORKS
WATER DIVISION

Lat 44

The undersigned applies for a supply of water at No. 5 AERIAL St. and hereby agrees to comply with the rules and regulations as now, or at any future time, established by the Board of Selectmen.

Am't. of Estimate \$ 18.⁰⁰

Owner Cleo D. Richardson


Am't. Paid \$ _____

Address 76 Pleasant Ave

Builder _____

Belmont Mass.

Sketch of Service Here

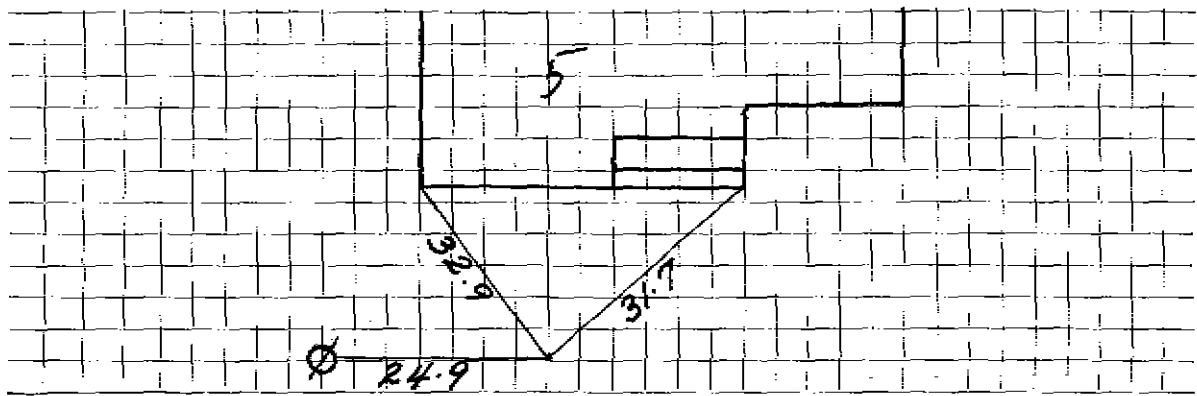

Connection made in _____ Street. Work completed _____ 19

Remarks: