

Name Harry E. Johnson

#6544  
Service No. 33 128

Address 50 Brighton Street, Belmont, Massachusetts  
#6 Aerial Street

(Street #6)  
Location Lot #19 Aerial Street

Kind of Pipe

Size

Size of Main

~~Repair-Removal~~ - New Service

Location

Date	Material	Amount	Total	Date	Amount
1938					
Aug. 5 <i>Cover</i> <i>8-16-38</i>	2 hrs. @ 60¢	1 20	1 20	<i>July 26, 1938 Deposited</i>	18 00
	33' 3/4" Cop. Tub. @ 20¢		7 60		
	1 3/4" S. & W.		3 75		
	2 hrs. Trucking @ 75¢		<u>1 60</u>		
			<u>14 05</u>		
	Flat Rate:				
		\$18.00			
	Labor				

Hadley Press, Inc., Lexington

DATE July 26, 1938

TOWN OF LEXINGTON—BOARD OF PUBLIC WORKS  
**WATER DIVISION**

The undersigned applies for a supply of water at No. Lot# 18 Aerial St. and hereby agrees to comply with the rules and regulations as now, or at any future time, established by the Board of Selectmen.

Am't. of Estimate \$ \_\_\_\_\_

Owner

*Hugh J. [unclear]*


Am't. Paid \$ \_\_\_\_\_

Address

*50 Bright St  
Belmont*

Builder \_\_\_\_\_

Sketch of Service Here

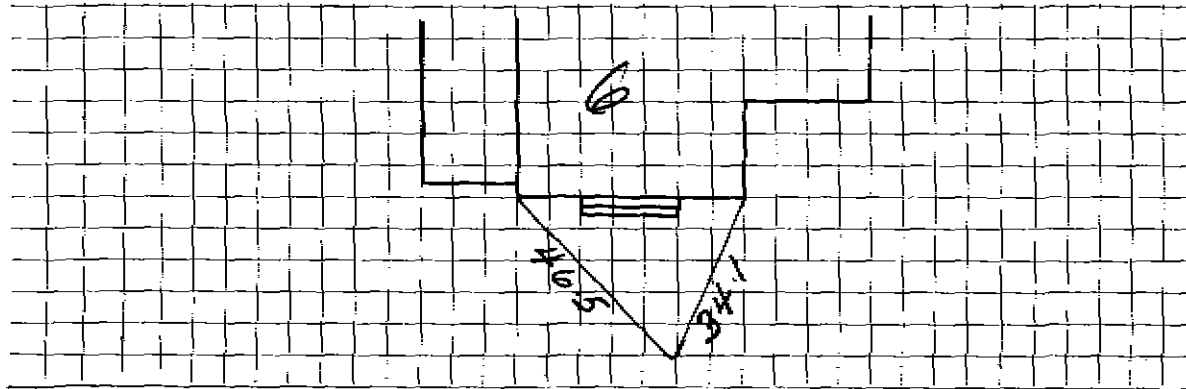

Connection made in \_\_\_\_\_ Street.

Work completed \_\_\_\_\_ 19

Remarks: