

Name Harry E. Johnson

Service No. 36 29

Address 50 Brighton Street, Belmont, Massachusetts

1544

~~50~~ Aerial St.

Location Lot # 23 Aerial Street

Kind of Pipe

Size

Size of Main

~~Repair~~ ~~General~~ - New Service

Location

Date 1938	Material	Amount	Total	Date	Location	Amount
Aug. 5.	2 hrs. @ 60¢		1 20	July 26, 1938	Deposited	18 00
<i>over</i> 8-16-38	38' 3/4" Copper Tubing @ 20¢		7 60			
	1 3/4" S. & W.		3 75			
	2 hrs. trucking @ 75¢		1 50			
			14 05			
	Flat Rate:					
	\$18.00					
	Labor					

Hantley Press, Inc., Lexington

DATE July 26, 1938.

TOWN OF LEXINGTON—BOARD OF PUBLIC WORKS
WATER DIVISION

The undersigned applies for a supply of water at No. Lot#23 Aerial St. and hereby agrees to comply with the rules and regulations as now, or at any future time, established by the Board of Selectmen.

Am't. of Estimate \$ _____

Owner

May [Signature]


Am't. Paid \$ _____

Address

50 Brighton St
Belmont

Builder _____

Sketch of Service Here

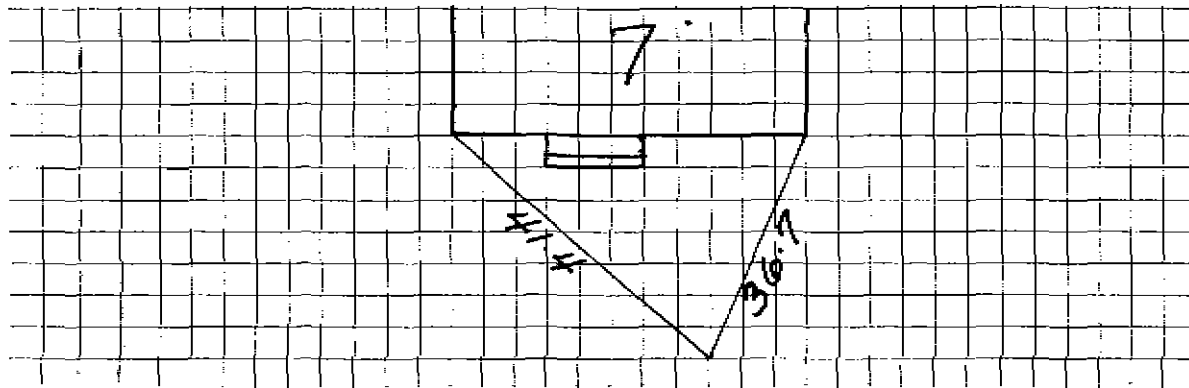

Connection made in _____ Street.

Work completed _____ 19

Remarks: