


DATE 7/6/18

TOWN OF LEXINGTON — BOARD OF PUBLIC WORKS
WATER DIVISION

Sketch of Service Here

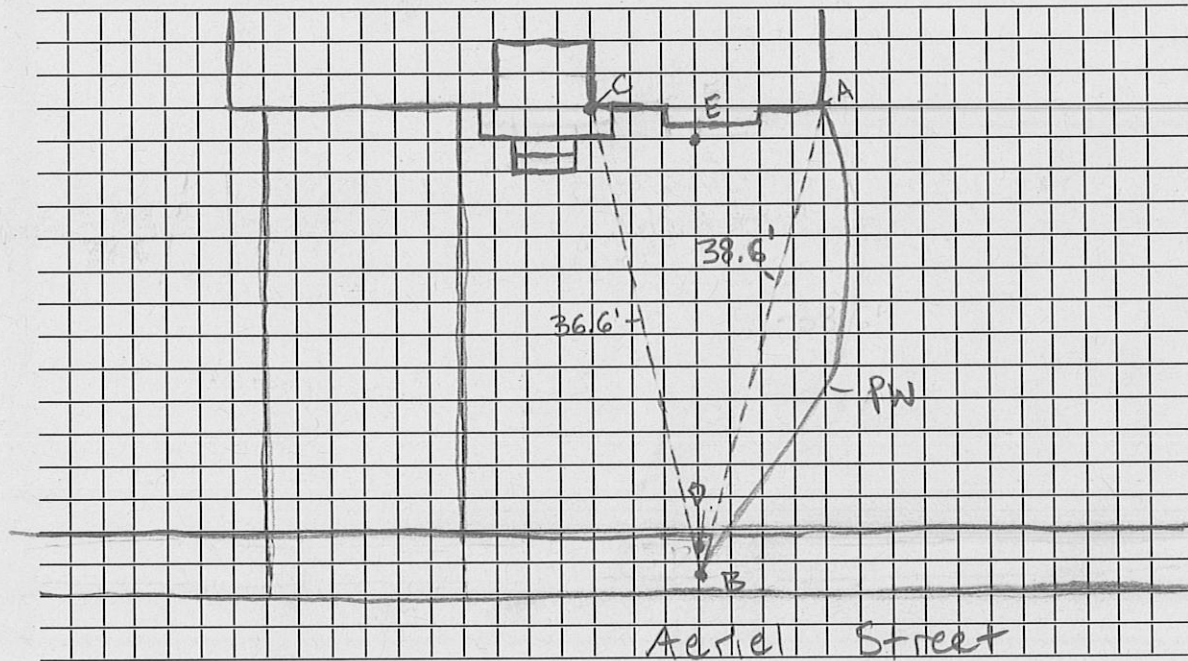

AB = 38.6'
CB = 36.6'

Connection made in Aerial Street. Work completed

Remarks: B = curb stop. 3/4" to 1" union, open right curb stop.