

Name Harry Johnson
 Address 50 Brighton Street
 # 9 Aerial St.
 Belmont, Mass.

Service No. 4431

Location Lot 22 Aerial Street

Kind of Pipe

Size

Size of Main

~~Repairs-Renewal~~—New Service

Location

Date	Material	Amount	Total	Date	Amount
1938					
Aug. 29	2 hrs. @ 60¢		1 20	August 9, 1938 Deposited	18 00
Aug 29 1938	36' 3/4" C. Tubing @ 20¢		7 20		
	1 3/4" W.E.S. & V.		3 75		
	Trucking- 2 hrs. @ 75¢		1 50		
			<u>13 65</u>		
	Flat Rate:				
	36' @ 50¢		18 00		
	Labor				

Hadley Press, Inc., Lexington

DATE July 9-37

TOWN OF LEXINGTON—BOARD OF PUBLIC WORKS

WATER DIVISION

The undersigned applies for a supply of water at No. Lat 22 Aerial St. and hereby agrees to comply with the rules and regulations as now, or at any future time, established by the Board of Selectmen.

Am't. of Estimate \$ _____

Owner

Harry E. Johnson

Am't. Paid \$ _____


Address

50 Brighton St

Builder _____

Bolton
by Eric Sakthig

Sketch of Service Here

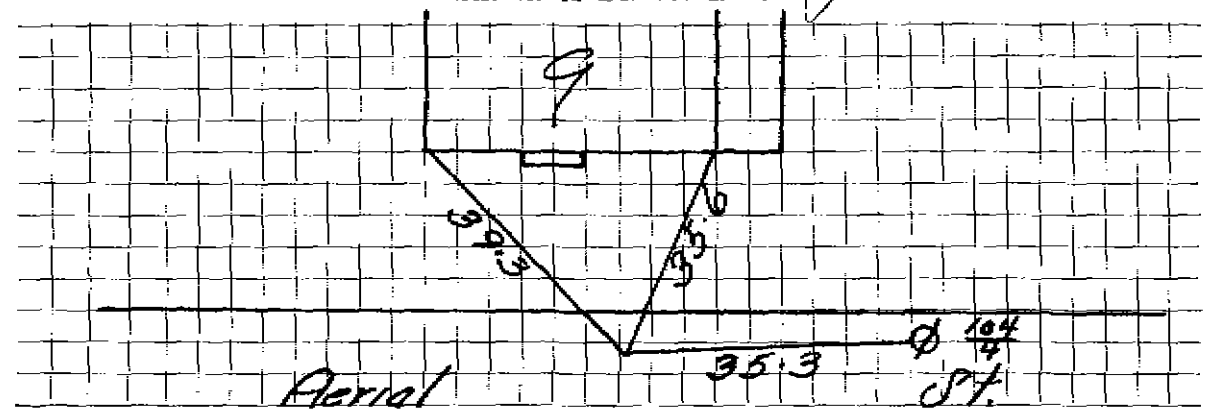

Connection made in _____ Street.

Work completed _____ 19

Remarks: