




DATE JAN. 5 1994

TOWN OF LEXINGTON — BOARD OF PUBLIC WORKS  
WATER DIVISION

Sketch of Service Here

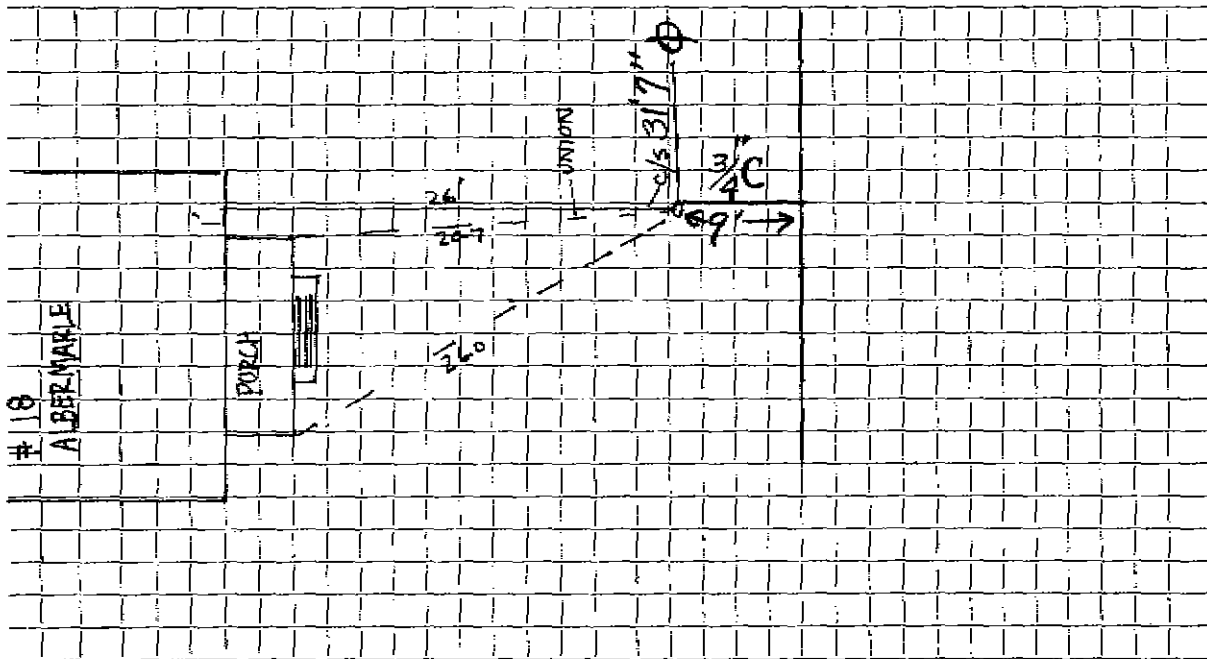

Connection made in ..... Street.

Work completed 11/1/93 VALEPI CONSTRUCTION

Remarks: .....  
.....  
.....