

WATER SERVICE RECORD

Name Edwin Herman

Service No. _____

Address 21 Albemarle Avenue

Location Lot #95 - 96 Sta. 5+15 left

Repair—Renewal—New Service E.R.Banks #4816


Date	Material	Amount	Total	Date	Amount
4/25/89	38' 3/4" Copper 3/4" Valve			4-21-89	Paid 36.77
					<i>OUTSIDE</i>
				22'	3/4" Copper tubing @.43 9.24
				1	3/4" Corp Cock 7.41
				1	3/4" Curb Cock 8.76
				1	Box & Rod 4.90
					Misc. (labor etc.) 6.46
					<u>36.77</u>

DATE _____

TOWN OF LEXINGTON — BOARD OF PUBLIC WORKS

WATER DIVISION

Sketch of Service Here

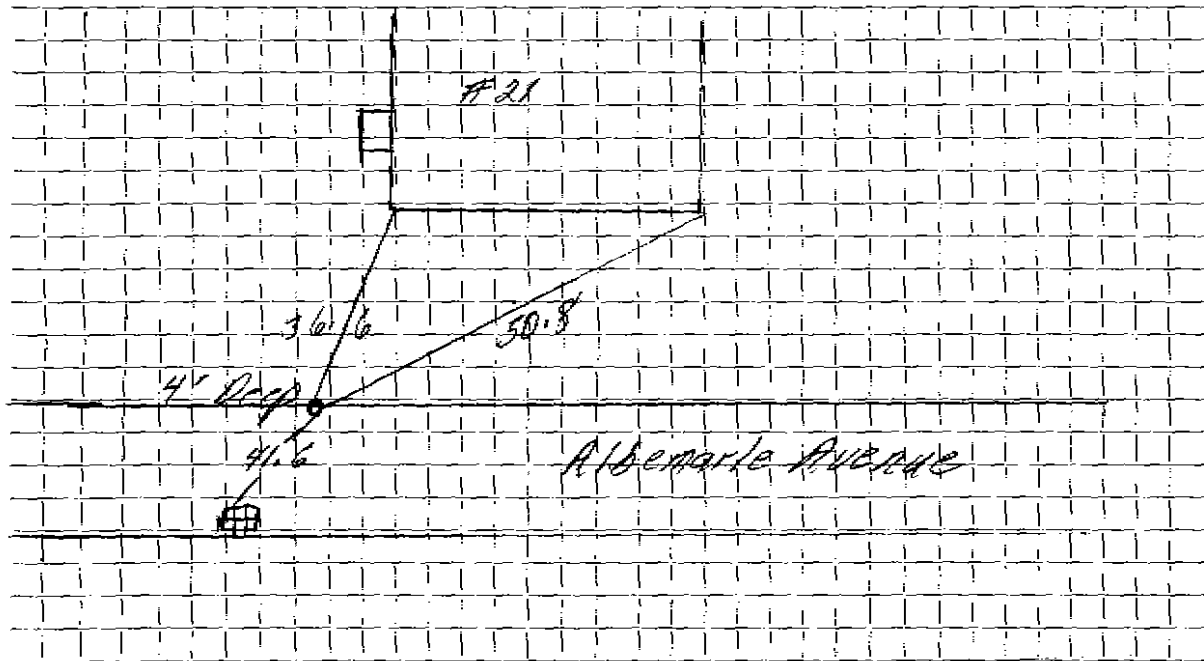

Connection made in Albemarle Ave Street. Work completed

Remarks: Curb 4 ft. deep