

WATER SERVICE RECORD

4916

Name Joseph G. Flynn

Service No. 121

Address 22 Albemarle Avenue

Location

~~Previous Record~~ - New Service W.O. #7594

Comm 12-10-62


Date	Material	Amount	Total	Date		Amount
9-25-62	Labor	60.60		9-12-62	Deposit	150.00
	10% O.H.	6.06	66.66	12-11-62	Refund	2.06
60'	3/4" Copper tubing @ 42		25.20			122.94
1	3/4" CX 1/2 I.W.H. Stop & Waste		6.17			
1	3/4" C 3 Part Union		2.41		NON CHARGE	
3	Hrs. Town Shovel @ 6.50		19.50	9-21-62	Labor	10.18
1	Hr. Trucking @ 3.00		3.00	10'	3/4" Copper tubing	4.20
			122.94	1	3/4" C Adapter	1.62
				1	3/4" Curb Cock	6.28
				1	Box & Rod	4.90
				1	Hr. Town Shovel @ 6.50	6.50
				1	Hr. Trucking : 3.00	3.00
						36.68

DATE _____

TOWN OF LEXINGTON — BOARD OF PUBLIC WORKS

WATER DIVISION

Sketch of Service Here

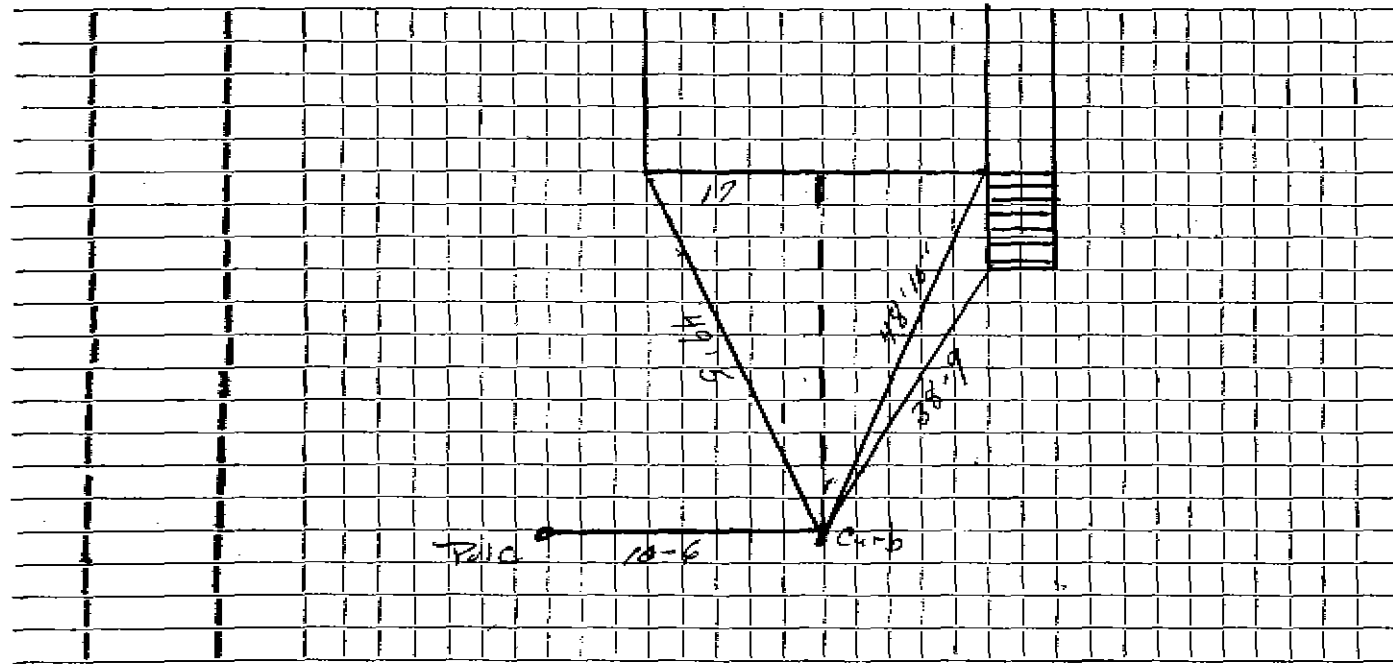

Connection made in _____ Street. Work completed _____

Remarks: _____

