

WATER SERVICE RECORD

Name N.Y. Brothers Realty Trust

Service No. 61

Address ~~78~~ ~~38~~ Albemarle Avenue

Location Lot #73-74 Sta. 3&15

~~84-87 & 88-91~~ New Service

DEC 18 1972


Date		Material	Amount	Total	Date	Amount
10/6/72	43'	3/4" Copper			9-12-72	160 00
					12-18-72	128 69
					Refund	31 31
					CURB TO MAIN	
					9-16-64 Labor	4.73
					10% O.H.	.47
					12' 3/4" Cop. tubing @ .42	5 20
					1 3/4" Corp cock	5 04
					1 3/4" Curb cock	7 41
					1 Box & Rod	8 76
						4 90
						31.31

DATE _____

TOWN OF LEXINGTON — BOARD OF PUBLIC WORKS

WATER DIVISION

Sketch of Service Here

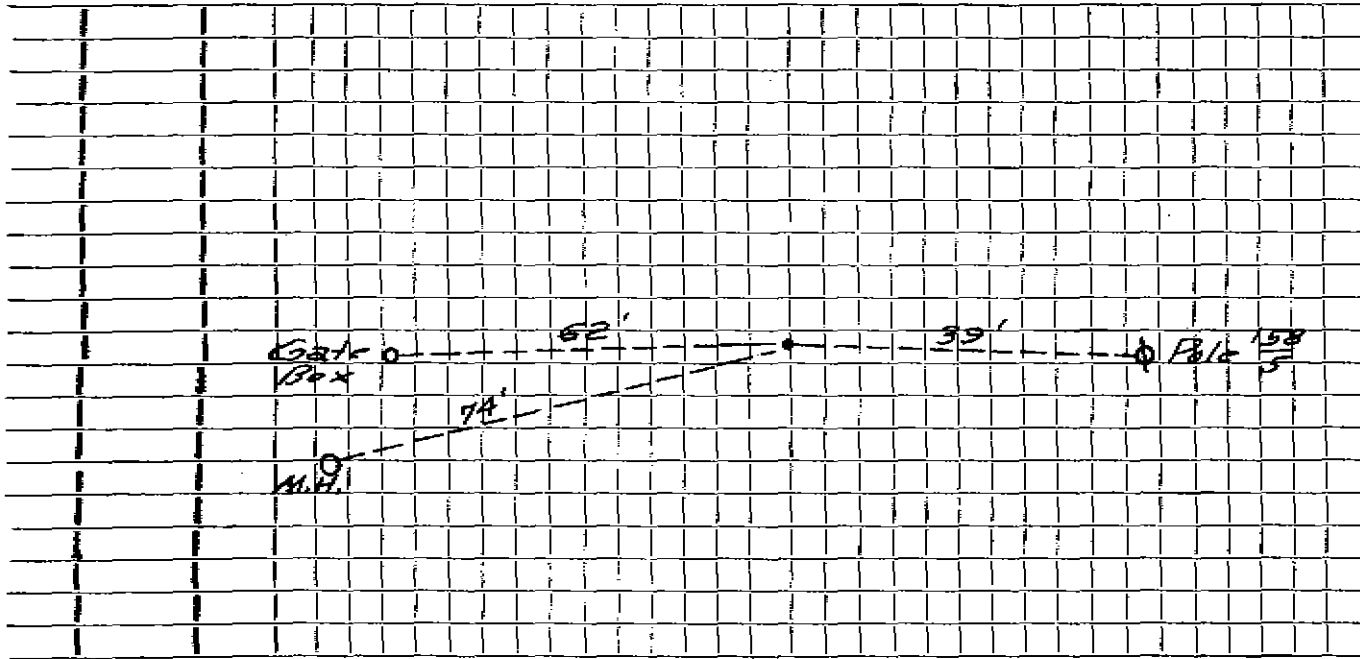

Connection made in Street. Work completed

Remarks:

.
.