

Name Wito Pierro

Service No.

Address 41 Albermarle Avenue

Lexington, Mass.

Location 41 Albermarle Avenue

Kind of Pipe

Size

Size of Main

~~Repair~~ - Renewal - ~~New Service~~

Com. 12-13-49

Location

Date	Material	Amount	Total	Date	Amount
------	----------	--------	-------	------	--------

Dec. 2, '49	Labor	1 30	1 30	Nov. 15 '49	10 00
	10% Overhead		13	January 9 '50	1 00
	23' - 3/4" Copper Tubing @.24		5 52		11 00
	1 - 3/4" C x 1/2" I.W.H. S&W		3 29	Dec. 2, '49	4 77
	Trucking 1 hr. @.75		75	24' - 3/4" Copper Tubing @.24	5 76
			10 99	1 - 3/4" C Corp-cock	3 15
				1 - 3/4" C x 3/4" Curb-cock	3 85
				1 - Box & Rod	3 75
				1 - 1/2" Offset Tail Piece	37
				1 - 1/2" Straight Tail Piece	37
				Trucking 1 hr. @.75	75
					22 40
	Labor				

Mont... 19

*Insulated
Gard
No Charge*

TOWN OF LEXINGTON.- BOARD OF PUBLIC WORKS

WATER DIVISION

The undersigned applies for a supply of water at No..... St. and hereby agrees to comply with the rules and regulations as now, or at any future time, established by the Board of Selectmen.

Am't of Estimate \$.....

Owner


Am't Paid \$.....

Address

Builder

.....

Sketch of Service Here

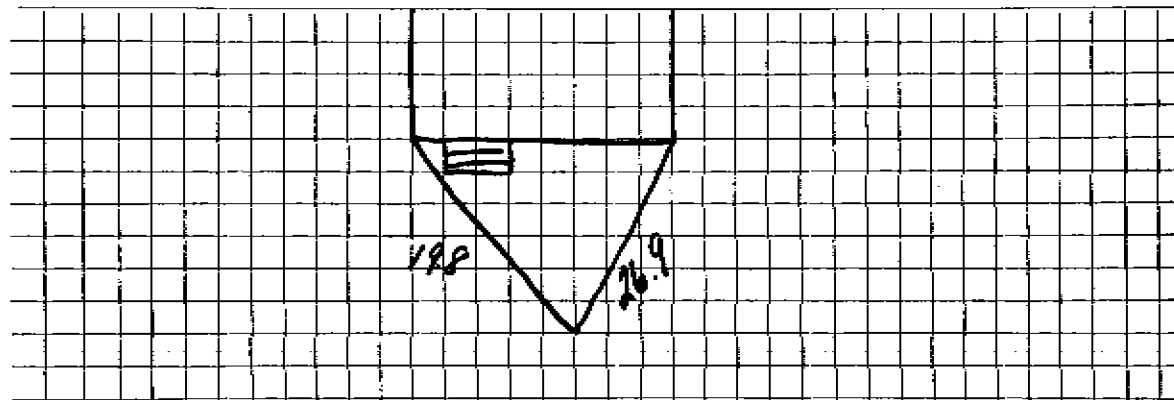

Connection made in Street.

Work completed19

Remarks: