

## WATER SERVICE RECORD

Name Peter Procopio

Service No. 229

Address 42 Albemarle Avenue

Location

Repair—Renewal—New Service


Comm. 11-19-56

Date	Material	Amount	Total	Date	Amount	
8/22/56	Labor	1 90		8-1-56	Deposit	50 00
	10% overhead	20	2 10	11-19-56	Refund	19 87
	46' 3/4" copper tubing @.4850		22 31		<u>NON CHARGES</u>	30 13
	1 3/4" C x 1/8" I.W.H. stop & waste		4 96		Labor	1 90
	1 hr. trucking @ .75		75		12' 3/4" copper tubing @.4850	5 82
			30 13		1 3/4" C Corp Cock	4 64
					1 3/4" C Carb Cock	5 94
					1 Box 'I & Rod	4 62
					1 1/2 Straight tail piece	50
					1 1/2 Offset tail piece	50
						23 92

DATE \_\_\_\_\_

**TOWN OF LEXINGTON — BOARD OF PUBLIC WORKS**  
**WATER DIVISION**

Sketch of Service Here

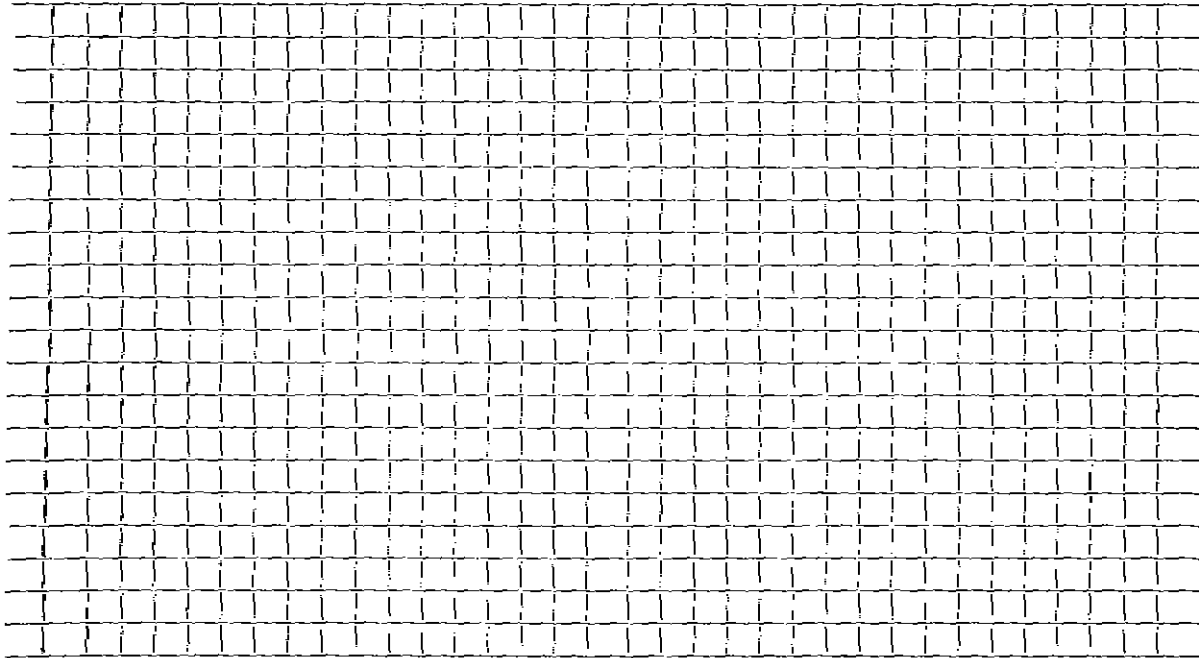

Connection made in ..... Street. Work completed .....

Remarks: .....  
.....  
.....