

WATER SERVICE RECORD

Name Joseph D. Augustine

Service No. 51

Address #48 Albemarle Ave

Location LOTS 63-66

Register ~~Remove~~ New Service DeFlice Bros. Permit #368

AUG 9 1965


Date	Material	Amount	Total	Date	Amount	
9-22-64	Labor 4.73			6-14-65	Deposit	12 23
9-23-64	" 4.73	9 46				
	10% O. H.	95	10 41			
	6' 3/4" Copper tubing @ .42		2 52			
			12 93		CURB TO MAIN	
7-1-65	28' 3/4" Copper tubing			10' 3/4" Cop. tubing @ .42	4 20	
				1 3/4" Corp. cock	7 41	
				1 3/4" Curb cock	8 76	
				1 Box & Rod	4 90	
					25 27	

DATE _____

TOWN OF LEXINGTON — BOARD OF PUBLIC WORKS

WATER DIVISION

Sketch of Service Here

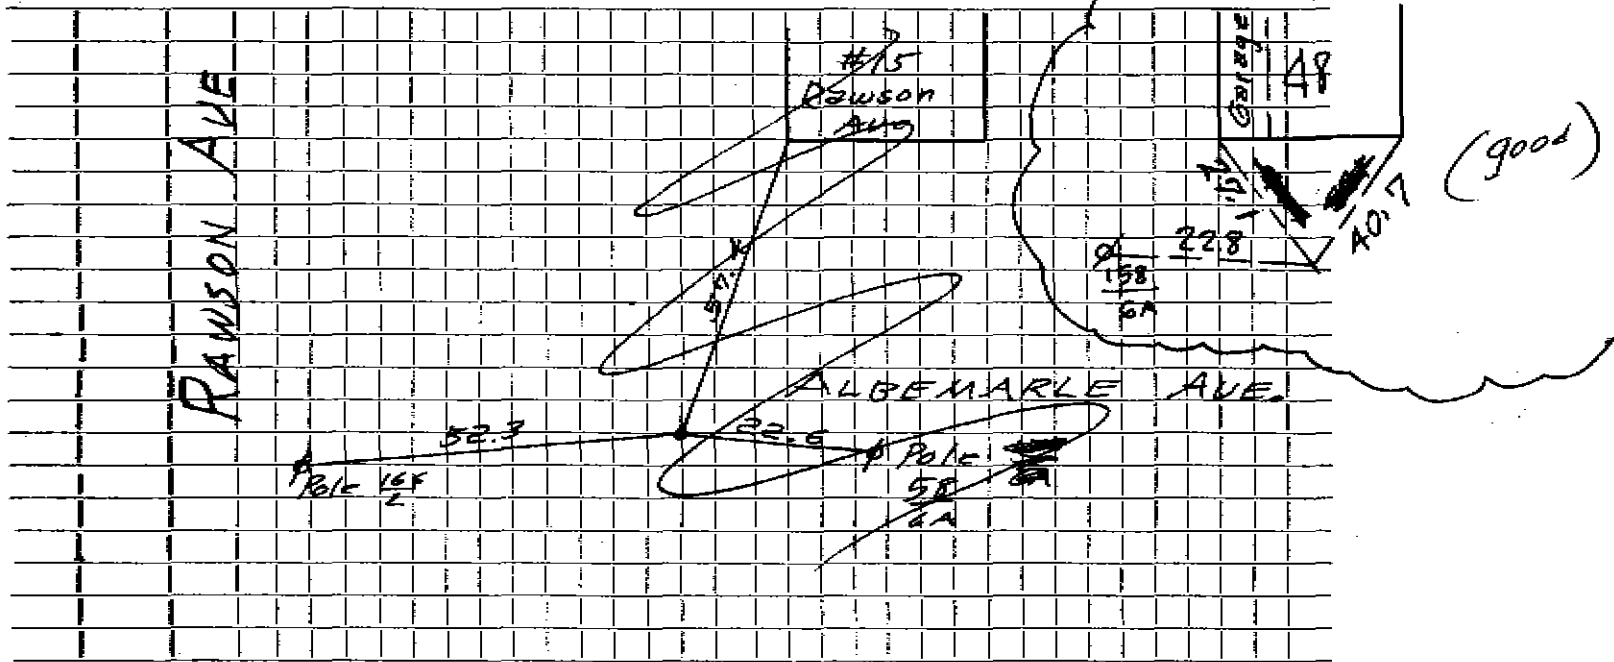

Connection made in Street. Work completed

Remarks:
.....
.....