

WATER SERVICE RECORD

Name Busa Realty Trust

Service No. 121

Address 54 Albemarle Avenue

# 8773

Location

~~Repair of Service~~ - New Service W.O. #8266

*Comm 2-10-64*


Date	Material	Amount	Total	Date		Amount
10-30-63	Labor	2.42		10-25-63	Deposit	35.00
	10% O.R.	.24	2.66	2-10-64	Paid by SHC #154	18.55
95'	3/4" Copper tubing @.42		39.90			53.55
1	3/4" C x 1/2 I.W.H. Stop & Waste		6.17		NON CHARGE	
2	3/4" C 3 part unions @2.41		4.82	1	1/2 Straight tailpiece	.50
			53.55	1	1/2 Offset tailpiece	.50
						1.00

DATE \_\_\_\_\_

TOWN OF LEXINGTON — BOARD OF PUBLIC WORKS

**WATER DIVISION**

Sketch of Service Here

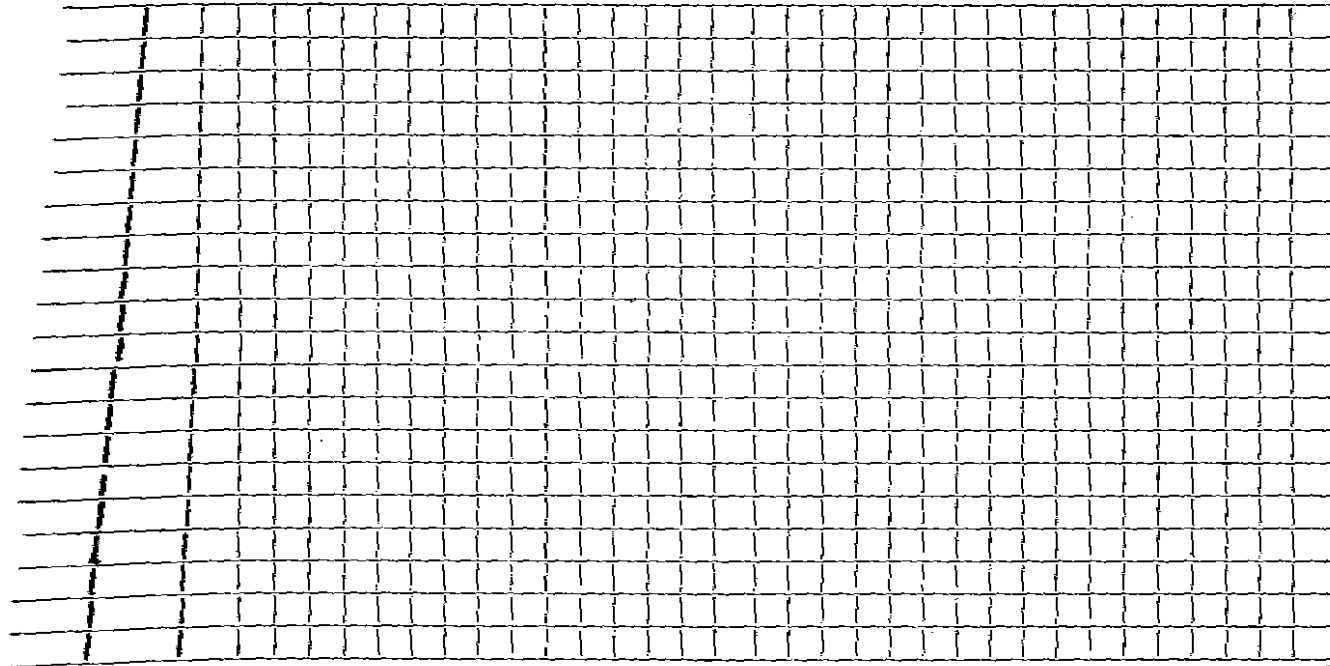

Connection made in ..... Street. Work completed .....


Remarks: .....  
.....  
.....

DATE \_\_\_\_\_

TOWN OF LEXINGTON — BOARD OF PUBLIC WORKS

**WATER DIVISION**

Sketch of Service Here

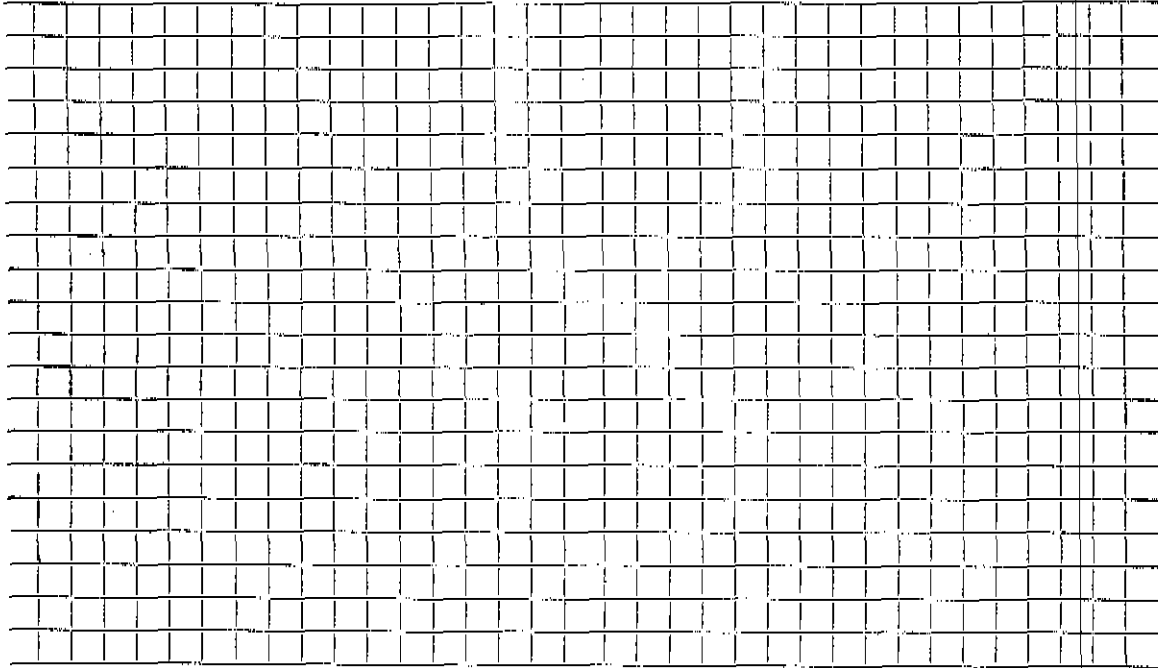

Work made in ..... Street.      Work completed .....

.....

.....

.....