


DATE _____

TOWN OF LEXINGTON — BOARD OF PUBLIC WORKS

WATER DIVISION

Sketch of Service Here

LOT 101

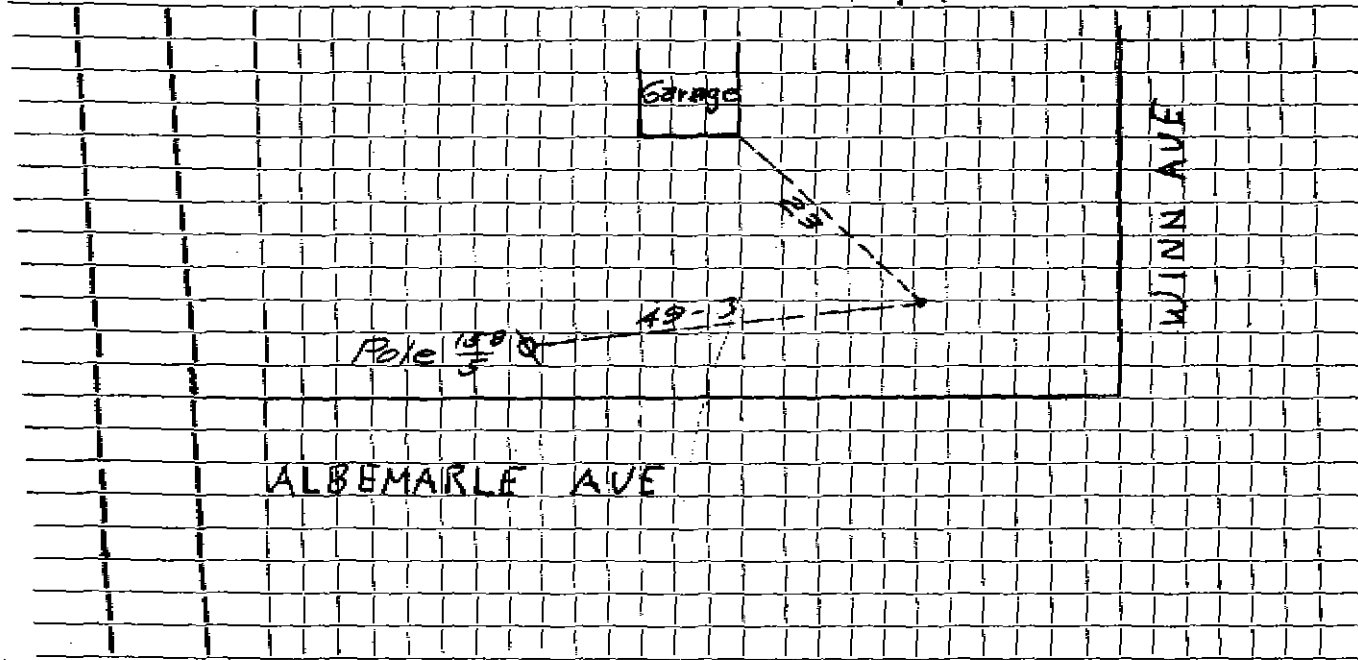

Connection made in _____ Street. Work completed _____

Remarks: _____

