

WATER SERVICE RECORD

#910

Name Busa Realty Trust

Service No. 122

Address 58 Albemarle Avenue

Location

~~SPRINKLER~~ - New Service W.O. #8267

Comm 2-10-64


Rate	Material	Amount	Total	Date		Amount
63	Labor	4.73		10-25-63	Deposit	35.00
	10% O.H.	.47	5.20	2-10-64	Paid by SHC #155	11.43
72'	3/4" Copper tubing @ .42		30.24			46.44
1	3/4" C x 1/2 I.W.H. Stop & Waste		6.17		NON CHARGE	
2	3/4" C 3 part unions @ 2.41		4.82		1 1/2 Straight tailpiece	50
			46.43		1 1/2 Offset tailpiece	50
						1.00

DATE \_\_\_\_\_

TOWN OF LEXINGTON — BOARD OF PUBLIC WORKS

WATER DIVISION

Sketch of Service Here

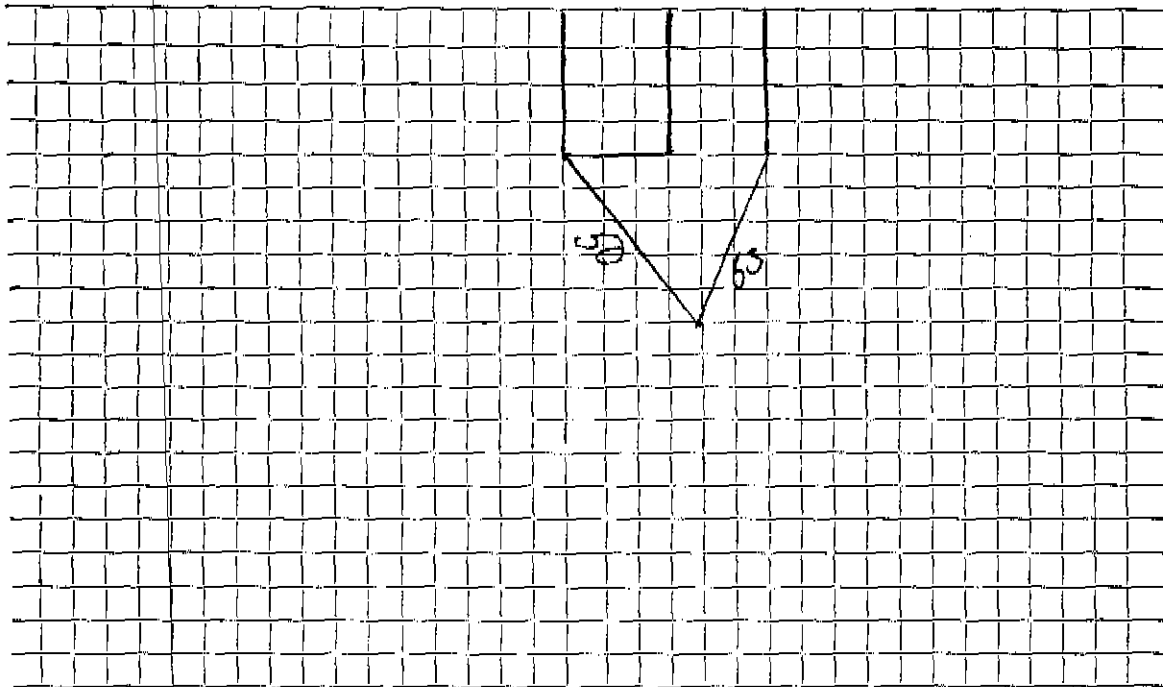

Connection made in ..... Street. Work completed .....

Remarks: .....  
.....  
.....