

WATER SERVICE RECORD

Name Busa Realty Trust

Service No. 123

Address 60 Albemarle Avenue

Location

~~Repair/ Renewal~~ New Service W.O. #8268


Comm 2-10-64

Date	Material	Amount	Total	Date		Amount
63	Labor	4.73		10-25-63	Deposit	35.00
	10% O.H.	.47	5.20	2-10-64	Paid by SHC# 156	12.80
81'	3/4" Copper tubing @.42		34.02			47.80
1	3/4" C x 1/8" I.W.H. Stop & Waste		6.17		NON CHARGE	
1	3/4" C 3 part union		2.41	1	1/8" Straight Tailpiece	.50
			47.80	1	1/8" Offset tailpiece	.50
						1.00

DATE _____

TOWN OF LEXINGTON — BOARD OF PUBLIC WORKS
WATER DIVISION

Sketch of Service Here

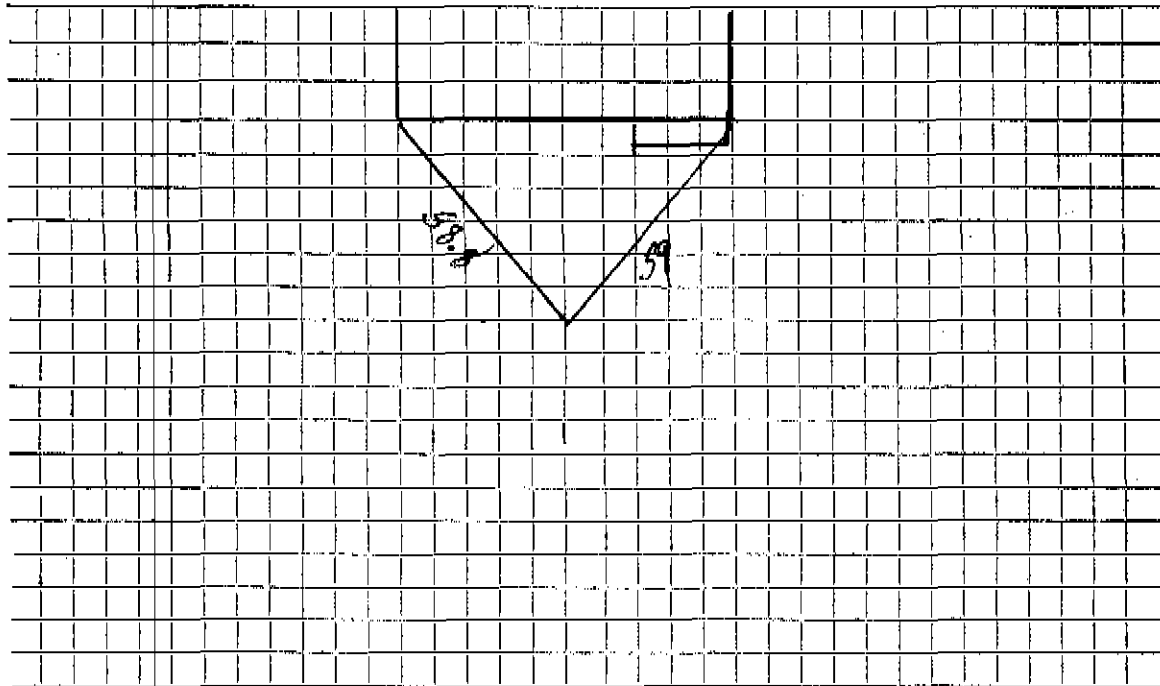

Connection made in Street. Work completed

Remarks:
.....
.....