

WATER SERVICE RECORD

Name Busa Realty Trust

Service No. #17

Address 11 Albemarle Avenue

7619

Location

~~Repair-Renewal~~ New Service W.O. #7087


Comm 6-25-62

Date	Material	Amount	Total	Date	Amount
4-16-62	Labor	28.17		3-27-62	Deposit 25.00
	10% O.H.	2.82	30.99	2-1-63	Paid 7.53
43'	3/4" Copper tubing @42		18.06		
1	3/4" Cx 1/2 I.W.H. Stop & Waste		6.17		
1	Hr. Town Shovel @6.50		6.50		Non Charge
1	Hr. Trucking @3.00		3.00	4-16-62	Labor 15.73
			64.72	24'	3/4" Copper tubing @42 10.08
				1	3/4" C Corp Cock 4.91
				1	3/4" C Curb Cock 6.28
				1	Box & Rod 4.00
				1	1/2 Straight Tailpiece .50
				1	1/2 Offset Tailpiece .50
					42.00

DATE _____

TOWN OF LEXINGTON — BOARD OF PUBLIC WORKS
WATER DIVISION

Sketch of Service Here

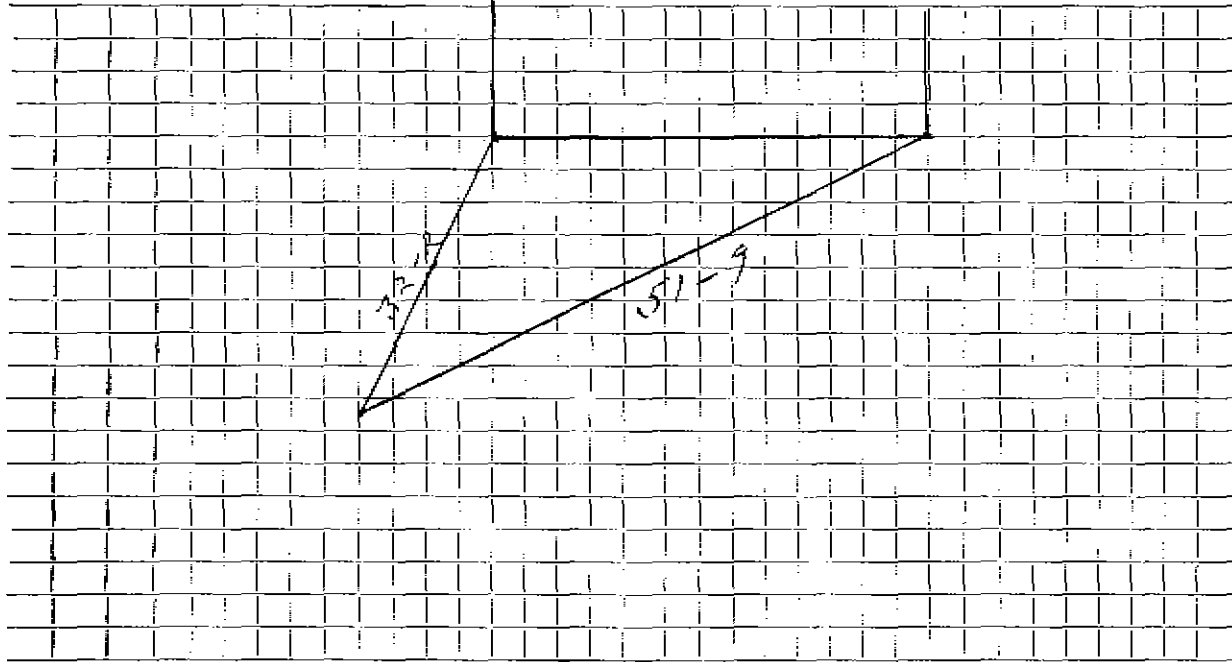

Connection made in Street. Work completed

Remarks:
.....
.....