

#8730

WATER SERVICE RECORD

Name Frederick Robicheau

Service No. #82

Address 15 Albemarle Avenue

Location

~~Repair/Reconnect~~ New Service

WO #7373

Comm 10-1-62


Date	Material	Amount	Total	Date	Amount	
6-25-62	Labor	2.13		6-25-62	Deposit	50.00
	10% O.H.	21	2.34	10-1-62	* Returned	19.62
52'	3/4" Copper tubing @.42		21.84			30.35
1	3/4" CX 1/2 I.W.H. Stop & Waste		6.17			
			30.35		NON CHARGE	
				6-25-62	Labor	1.70
					21' 3/4" Copper tubing @.42	8.82
					1 3/4" C Corp Cock	4.91
					1 3/4" C Curb Cock	6.28
					1 Box & Rod	4.90
					1 1/2 Straight tailpiece	.50
					1 3/8 Offset Tailpiece	.50
						27.61
					* Applied to SHC #96	3.69

DATE _____

TOWN OF LEXINGTON — BOARD OF PUBLIC WORKS

WATER DIVISION

Sketch of Service Here

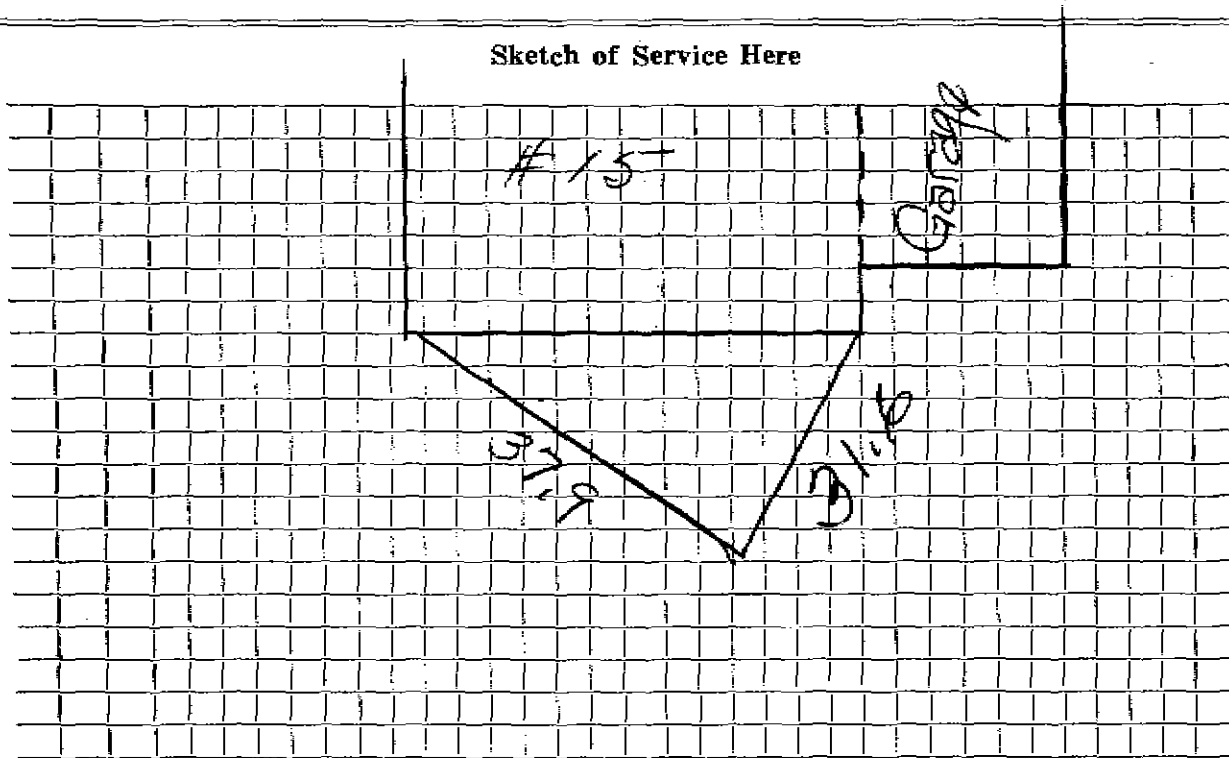

Connection made in Street. Work completed

Remarks:
.....
.....