

WATER SERVICE RECORD

1147

Service No. 251

Name Anthony Buss

Address ~~12 Rowson Ave.~~, Lexington

Location 52 Albermarle Ave

~~Repair - Renewal~~ New Service

Digging own trenches

Comm. 10-29-56


Date	Material	Amount	Total	Date	Amount
8/21/56	Labor	1 95		8-21-56 Deposit	# 10 00
	10% Overhead	20	2 15	10-29-56 Refund	# 2 14
	Owners Copper			<u>NON CHARGE</u>	# 7 86
	1-3/4" C x 1/2 I.W.F. stop & waste	4 96		30'-3/4" Copper tubing @.4850	14 55
	1 hr. trucking @.75		75	1-3/4" C Corp Cock	4 64
			7 86	1-3/4" C Curb Cock	5 94
				1 Box & Rod	4 62
				1-1/2 straight tail piece	50
				1-1/2 offset tail piece	50
					<u>32 70</u>

DATE _____

TOWN OF LEXINGTON — BOARD OF PUBLIC WORKS

WATER DIVISION

Sketch of Service Here

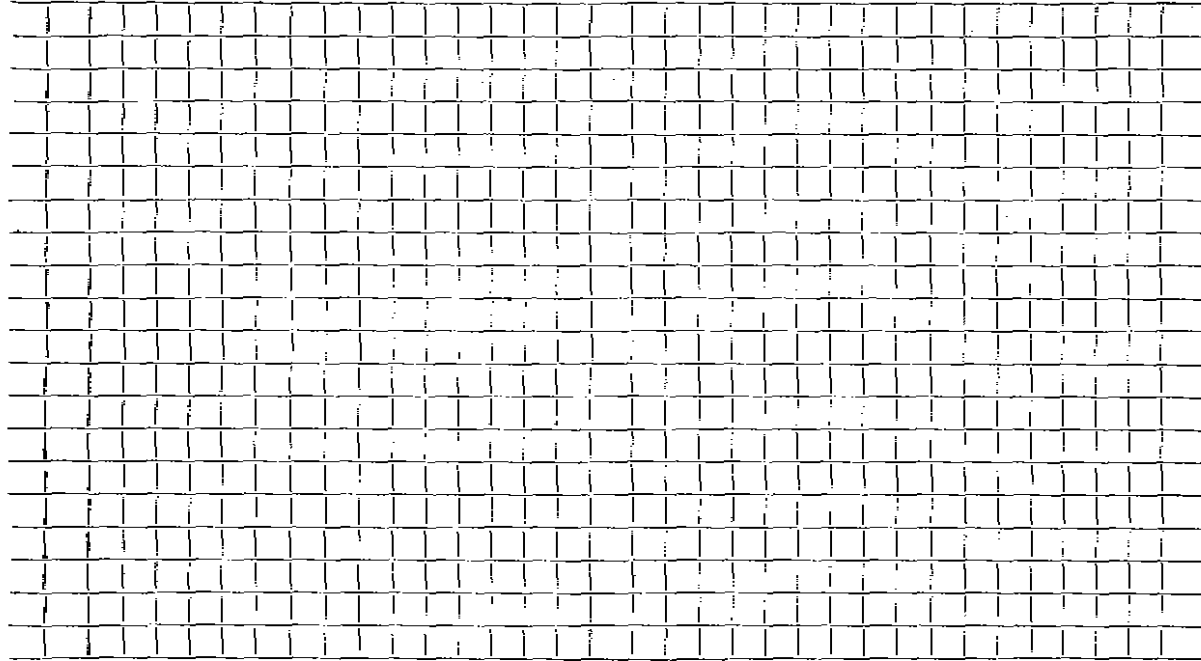

Connection made in Street. Work completed

Remarks:
.....
.....