

WATER SERVICE RECORD

#4233

Name Richard Hemstreet

Service No. 390

Address 6 Albermarle Avenue

Location Lexington, Mass.

Repair—Renewal—~~New Service~~


Com. 1231-50

Date	Material	Amount	Total	Date	Amount
Sept. 13, '50	Labor	1 30	1 30	7-2-54	16 12
	10% Overhead		13		
	37' - 3/4" Copper Tubing @.275	10 18	10 18		
	1 - 3/4" C x 1/2" I.W.H. S&W	3 76	3 76		
	Trucking 1 hr. @.75		75		
			16 12		
				Sept. 13, '50	1 30
				7' - 3/4" Copper Tubing @.275	1 93
				1 - 3/4" Corp-cock	3 60
				1 - 3/4" C x 3/4" Curb-cock	4 40
				1 - Box ' Rod	3 35
				1 - 1/2" Offset Tail Piece	42
				Trucking 1 hr. @.75	75
					15 75
				3/4/85	1
					Ford Clamp 6x7 1/2
					Patch - 18'x8'

DATE _____

TOWN OF LEXINGTON — BOARD OF PUBLIC WORKS
WATER DIVISION

Sketch of Service Here

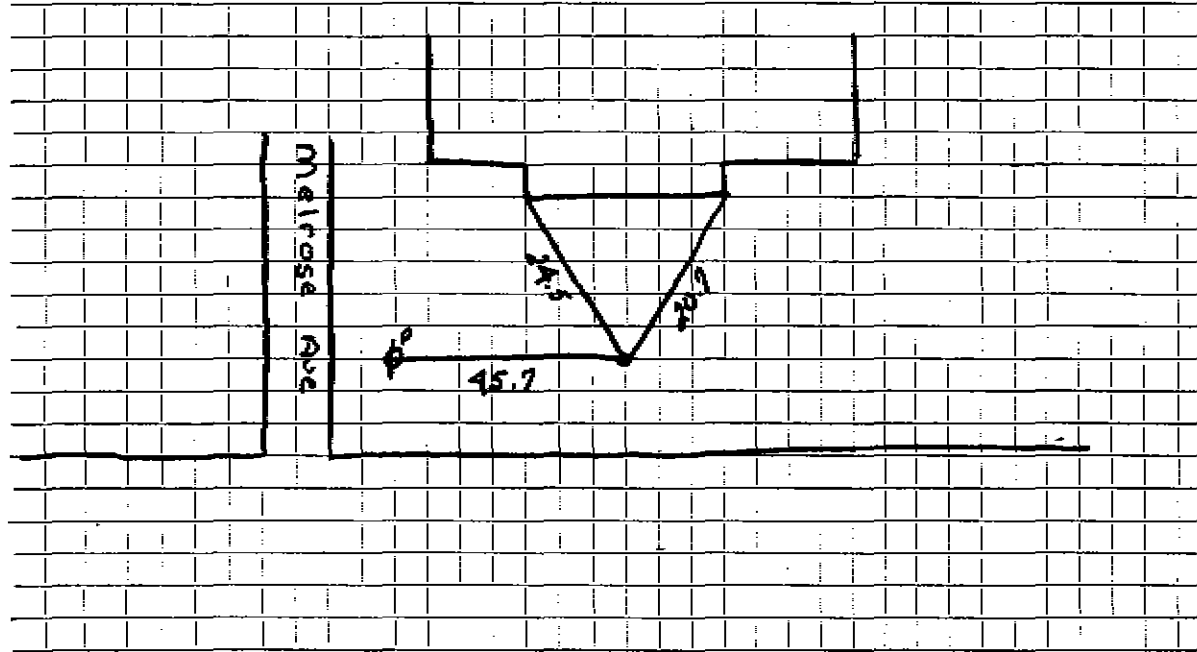

Connection made in Street. Work completed

Remarks:

.....
.....