

WATER SERVICE RECORD

328

Name Francis Thompson

Service No. 23

Address 7 Albermarle Avenue

6866

Location

~~REPAIR~~ - Renewal - ~~REPAIR~~ W.O. #2241


OCT 3 1966

Date	Material	Amount	Total	Date		Amount
5/6/66	Labor	51 20		5-3-66	Deposit	100 00
	10% O.H.	5 12	56 32	10-3-66	Refund	2 64
26'	3/4" copper tubing @ .79		20 54			97 36
2 1/2	Hrs. Town Truck @ 3.00		7 50		Non Charge	
2	Hrs. Tractor @ 6.50		13 00	10/29/57	Labor	47 26
			97 36			
					15' 3/4" Copper Tubing @ .375	5 63
					1 3/4" C Corp Cock	4 64
					1 3/4" C Curb Cock	5 94
					1 Box & Rod	4 62
					4 Hrs. Town Shovel @ \$6.50	26 00
					3 Hrs. Trucking @ .75	2 25
						96 34

DATE _____

TOWN OF LEXINGTON — BOARD OF PUBLIC WORKS
WATER DIVISION

Sketch of Service Here

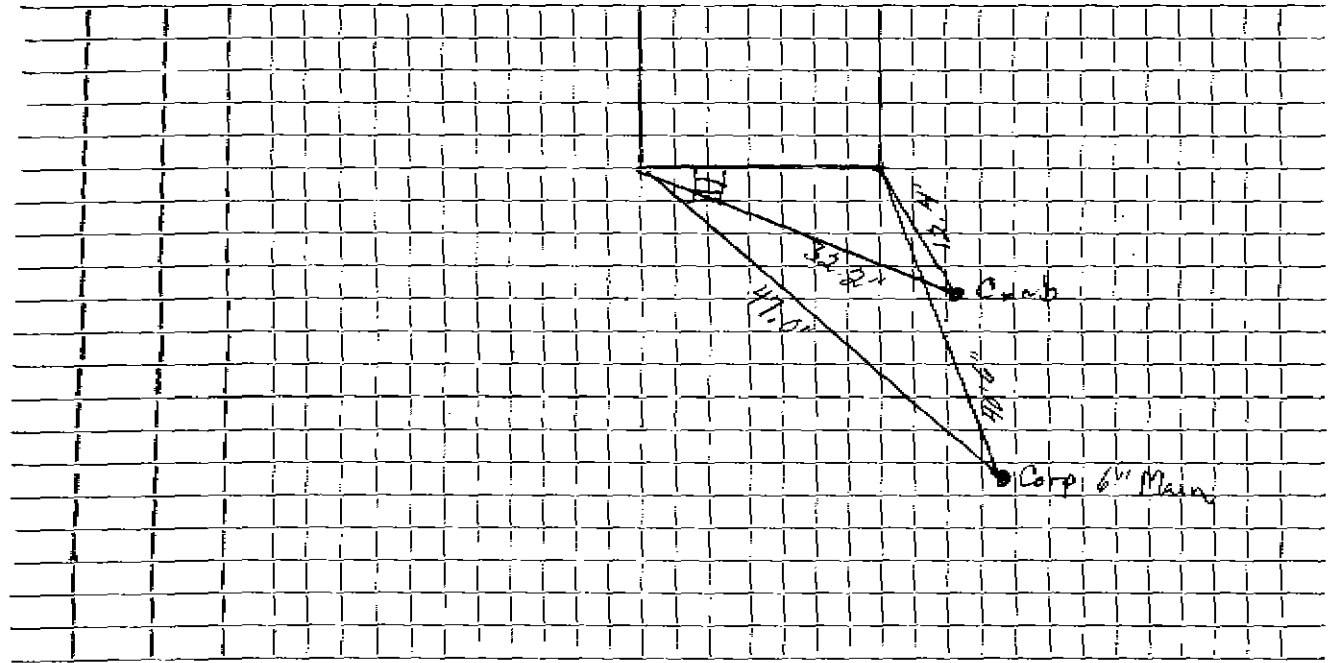

Connection made in Street. Work completed

Remarks:
.....
.....