

Name Pellegrino Ferri

Service No. #1942

Address Albemarle Avenue

Location Garden service, Belrose Ave.

Kind of Pipe

Size

Size of Main

~~Repair - Renewal~~ - New Service

Location

Date

Material

Amount

Total

Date

Amount

6/3/32

3' 2" G.I. Pipe 1.27

51

Com 5.01

2 1" I.L. Coupl. 1.25

50

6-21-32

1 1" Er. Sp. Wipple

25

1

3 00

Trucking

75

35 01

July 2 1932 - Cash

35 01

Labor by owner

DATE _____

TOWN OF LEXINGTON—BOARD OF PUBLIC WORKS

WATER DIVISION

The undersigned applies for a supply of water at No. _____ St. and hereby agrees to comply with the rules and regulations as now, or at any future time, established by the Board of Selectmen.

Am't. of Estimate \$ _____


Owner _____

Am't. Paid \$ _____

Address _____

Builder _____

Sketch of Service Here

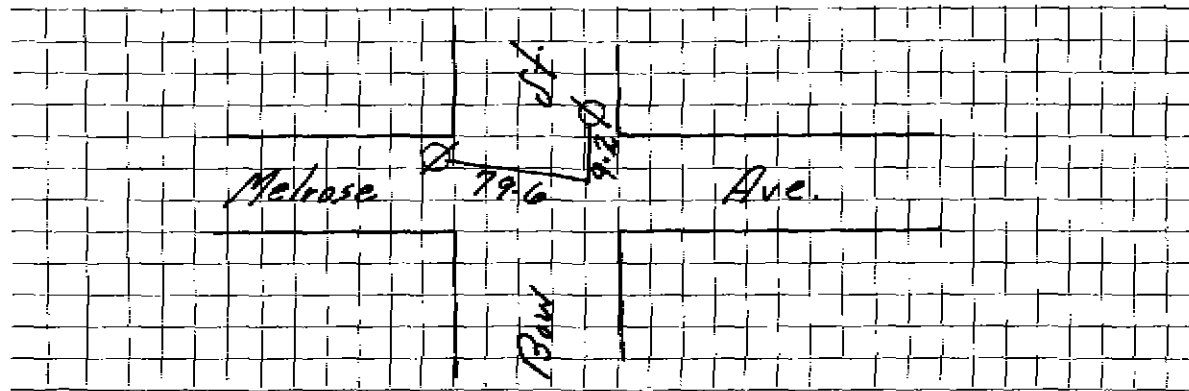

Connection made in _____ Street.

Work completed _____ 19

Remarks: