


DATE _____

TOWN OF LEXINGTON — BOARD OF PUBLIC WORKS
WATER DIVISION

Sketch of Service Here

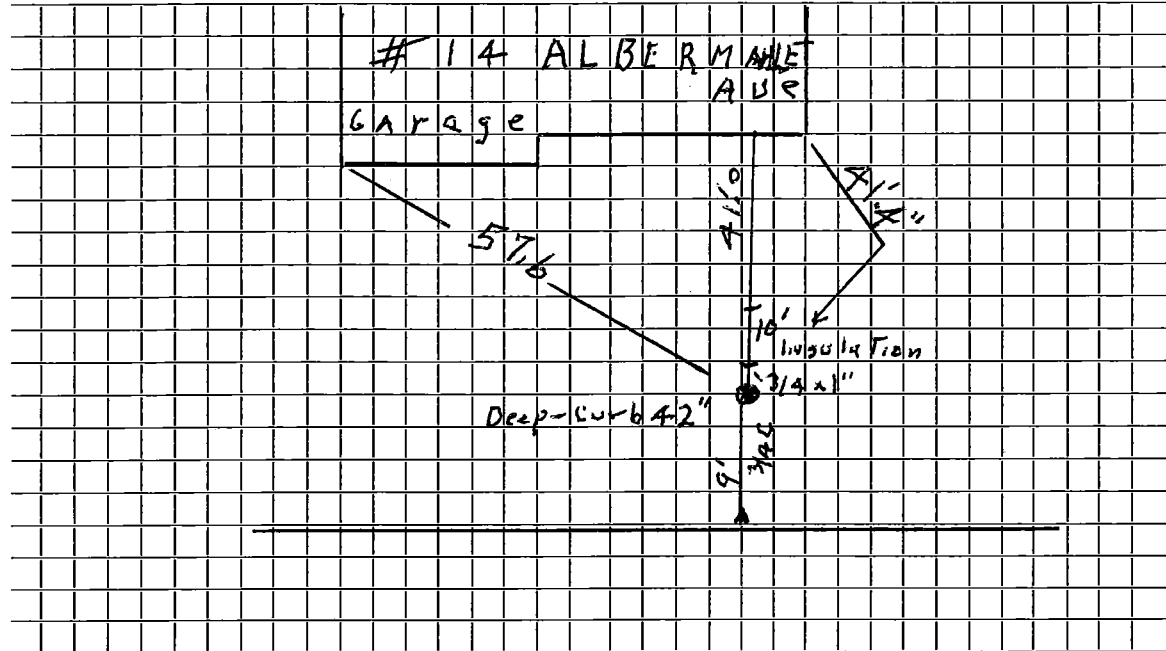

Connection made in Street. Work completed

Remarks: *EXIST. 3/4 COPPER 1/2 ST. - DYNAMITE USED.*

.....
.....