

WATER SERVICE RECORD

4743

Name Foley Const. Co.

Service No. 104

Address 10 Alcott Road

Location Lot #25


~~Repair~~ ~~Renewal~~ New Service

Comm. 8-3-59

Date	Material	Amount	Total	Date	Material	Amount
6-8-59	Labor	3.90		5-27-59	Deposit	50.00
	10% O.H.	.39	4.29	8-3-59	Refund	8.00
75'	3/4" Copper tubing @.3764		28.23			41.44
1	3/4" C x 1/2 I.W.H. Stop & Waste		5.88		NON CHARGE	
1	3/4" C 3 part Union		2.30	10-18-58	Labor	6.20
1	hr. Trucking @.75		.75	22'	3/4" Copper tubing @.37	8.10
			41.45	1	3/4" C Corp Cock	4.60
				1	3/4" C Curb Cock	6.00
				1	Box & Rod	5.00
						30.00
				1	1/2 Straight tailpiece	.50
				1	1/2 Offset tailpiece	.50
						31.00

DATE _____

TOWN OF LEXINGTON — BOARD OF PUBLIC WORKS
WATER DIVISION

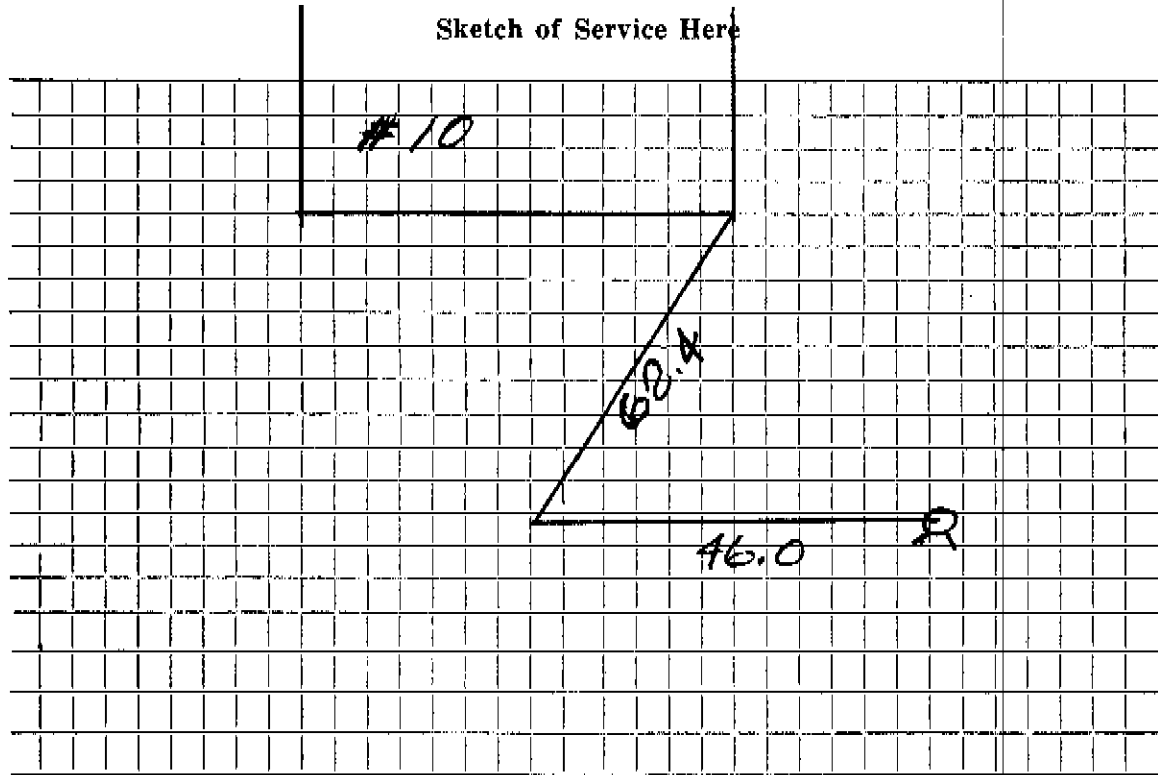

Connection made in Street. Work completed

Remarks:

.....

.....