

WATER SERVICE RECORD

Name Acme Builders

Service No. 124

Address 11 Alcott Road

Location Lot #26

~~XXXXXXXXXX~~ New Service

Comm 7-6-59


Date	Material	Amount	Total	Date	Material	Amount
7-59	Labor	1 77		6-15-59	Deposit	50 00
	10% O.H.	18	1 95	7-6-59	Retard	23 15
50'	3/4" Copper Tubing @3686		18 33			26 87
1	3/4" Cx 1/2" IWH Stop & Waste		5 84		NON CHARGE	
1	Hour Trucking @.75		75	10-18-58	Labor	6 23
			26 87	22'	3/4" Copper tubing @.37	8 11
				1	3/4" C Corp Cock	1 61
				1	3/4" C Curb Cock	6 03
				1	Box & Rod	5 00
						30 01
				1	1/2" Straight tailpiece	50
				1	1/2" Offset tailpiece	50
						31.04

DATE 3/8/59

TOWN OF LEXINGTON — BOARD OF PUBLIC WORKS

WATER DIVISION

Sketch of Service Here

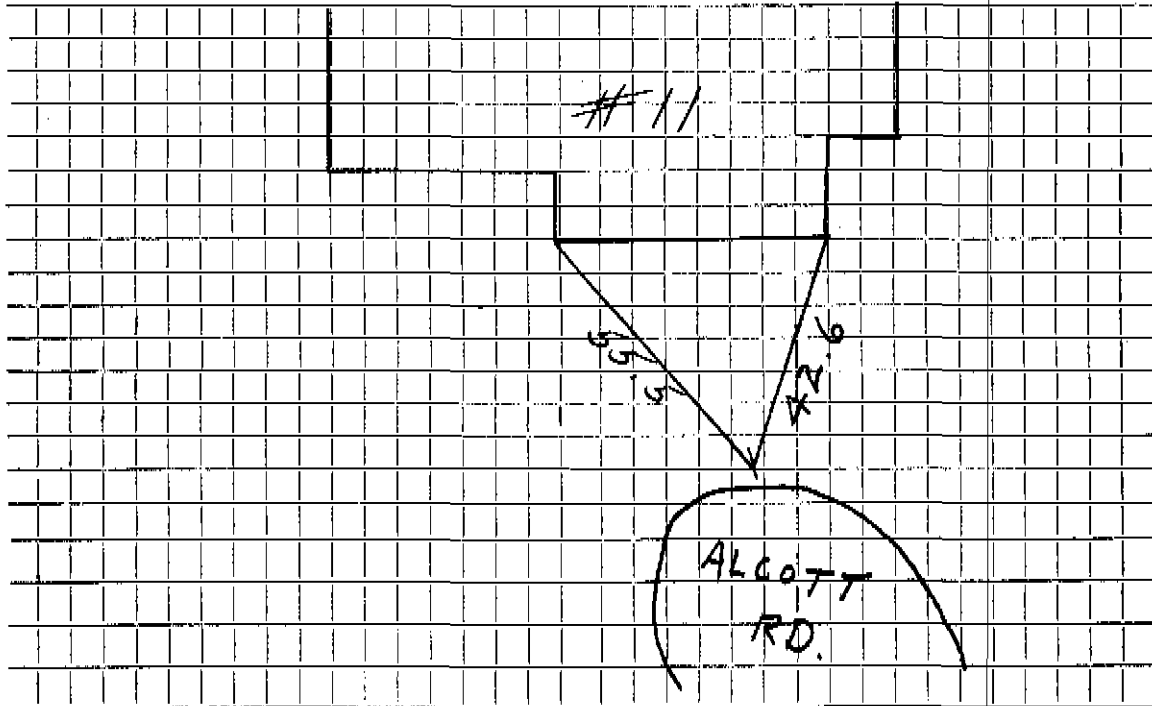

Connection made in ALCOTT RD. Street. Work completed .....

Remarks: .....