

WATER SERVICE RECORD

Name Louis Stoico

Service No. 117

Address 4 Alcott Road

3920

7585

Location Lot #22

3921

~~Repair~~ ~~Renewal~~ New Service

3922


Order 8-3-58

Date	Material	Amount	Total	Date	Material	Amount
-10-59	Labor	1.77		6-9-59	Deposit	41
	10% O.H.	.18	1.95	8-3-59	Retained	9
	58' 3/4" Copper tubing @.3764		21.83			30
	1 3/4" C x 1/2" I.W.H. Stop & Waste	5.88			NON CHARGE	
	1 hr. Trucking @.75	.75		10-18-58	Labor	5
			30.41		18' 3/4" Copper tubing @.37	6
					1 3/4" C Corp Cock	4
					1 3/4" C Curb Cock	4
					1 Box & Rod	27
					1 1/2" Straight tailpiece	
					1 1/2" Offset tailpiece	

DATE _____

TOWN OF LEXINGTON — BOARD OF PUBLIC WORKS
WATER DIVISION

Sketch of Service Here

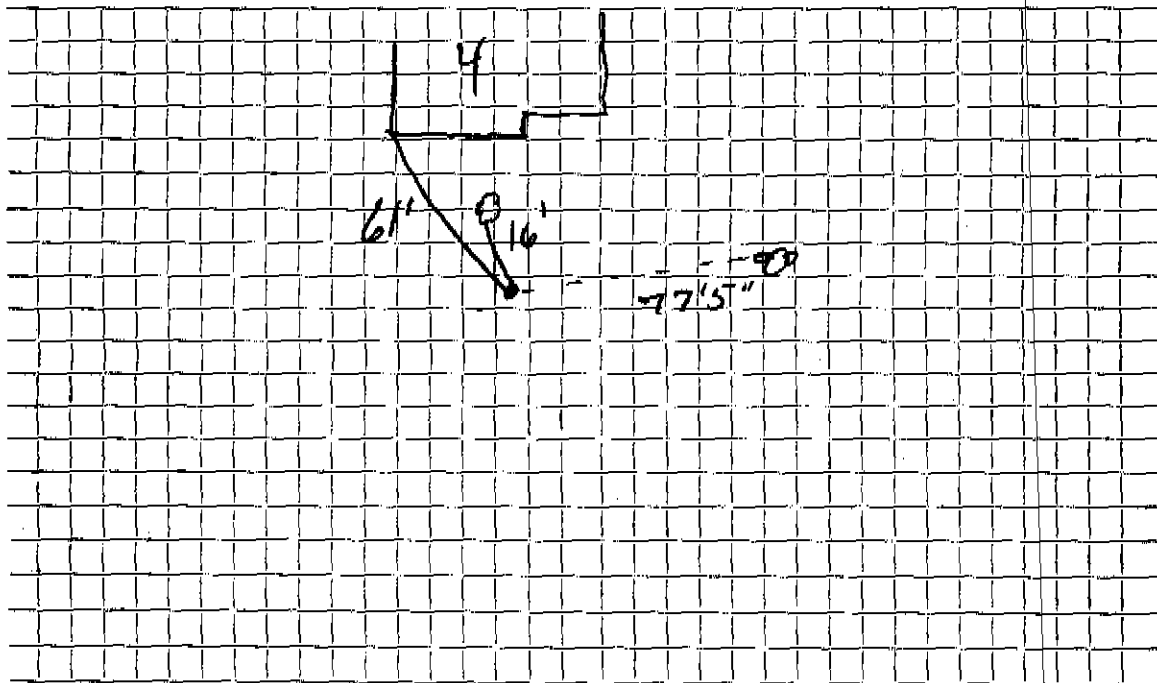

Work made in Street. Work completed

Notes:

.....

.....