

WATER SERVICE RECORD

Name Leonard Colwell

Service No. 266

Address 5 Alcott Road

Location Lot 29

Repair—Renewal—New Service

Comm 12-58

Date	Material	Amount	Total	Date		Am
10-21-59	Labor	9.66		10-19-59	Deposit	1
	10% G.H.	.97	10.63	12-14-59	* Re-Used	
115'	3/4" Copper tubing @.42		48.30			2
1	3/4" C x 1/2 I.W.H. Stop & Waste		5.88		NON CHARGE	
1	Box & Rod		4.90	10-18-58	Labor	
1	3/4" C 3 part union		2.27	29'	3/4" Copper tubing .37	10
1	hr. Trucking @.75		.75	1	3/4" C Corp Cock	
			72.73	1	3/4" C. Curb Cock	
				1	Box & Rod	3
				10-21-59	1 1/2 Straight Tailpiece	
					1 1/2 Offset Tailpiece	3


* Applied to 3/4" Curb Cock

DATE

TOWN OF LEXINGTON — BOARD OF PUBLIC WORKS

WATER DIVISION

Sketch of Service Here

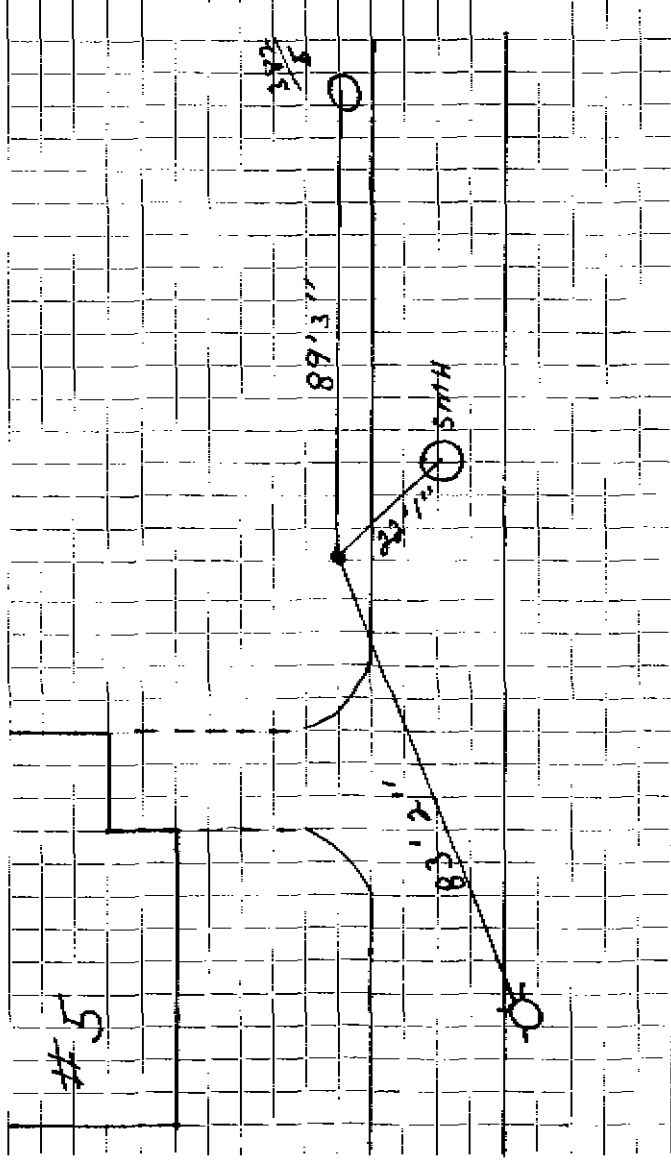

Location made in Street. Work completed

Notes:

.....

.....