

WATER SERVICE RECORD

Name Leonard Colwell

Service No. 142

Address 7 Alcott Road

Location Lot #29

~~Repair - Renewal~~ New Service

Comm. 10-1959


| Date | Material | Amount | Total | Date | Amount |
|---------|----------------------------------|--------|-------|----------|--------------------------------|
| 3-24-59 | Labor | 1.77 | | 6-23-59 | Deposit 7.50 |
| | 10% O.H. | .18 | 1.95 | 11-19-59 | * Retard 1.00 |
| 118' | 3/4" Copper tubing @ .3764 | | 44.42 | | |
| 1 | 3/4" C x 1/2 I.W.H. Stop & Waste | | 5.88 | | NON CHARGE |
| 1 | 3/4" 3 part union | | 2.30 | 10-18-58 | Labor 9.00 |
| 1 | hr. Trucking @ .75 | | .75 | 32' | 3/4" Copper tubing @ .37 11.00 |
| | | | 55.30 | 1 | 3/4" C Corp Cock 4.00 |
| | | | | 1 | 3/4" C Curb Cock 6.00 |
| | | | | 1 | Box & Rod 5.00 |
| | | | | | 36.00 |
| | | | | 1 | 1/2 Offset Tailpiece |
| | | | | 1 | 1/2 Straight tailpiece |
| | | | | | 3.00 |

* Applied to S/P #132 (1958)

DATE 3/8/59

TOWN OF LEXINGTON — BOARD OF PUBLIC WORKS
WATER DIVISION

Sketch of Service Here

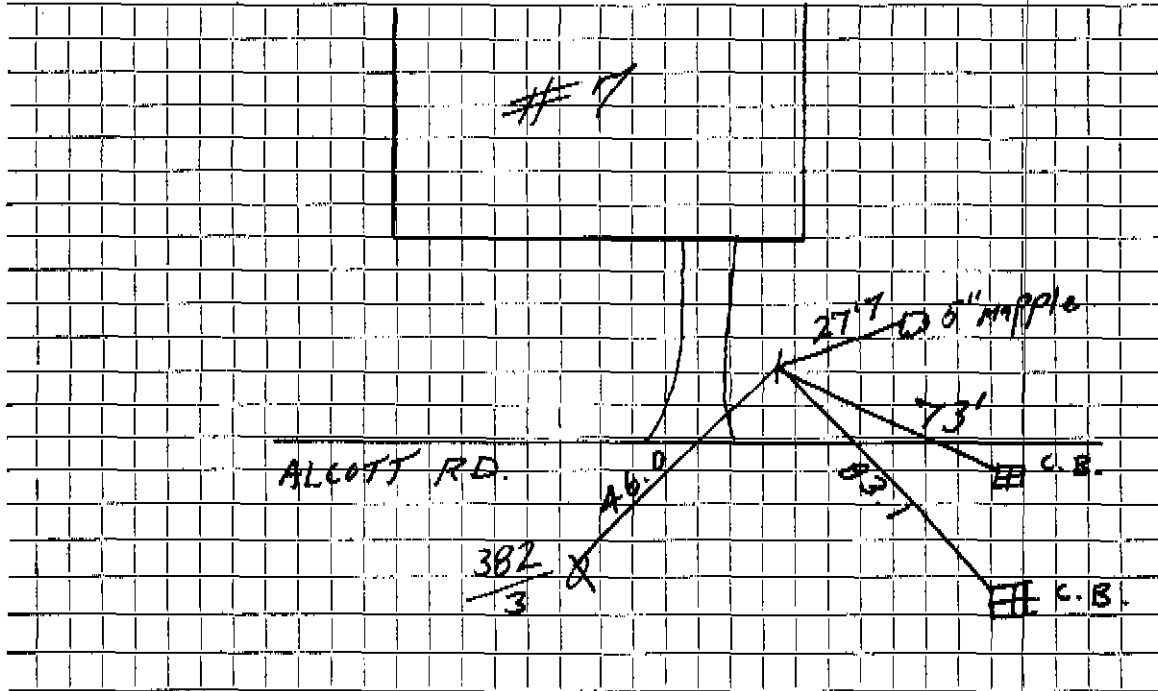

Section made in ALCOTT RD. Street. Work completed

marks:

.....

.....