

WATER SERVICE RECORD

Name

Service No.

Address

Location 8 ALCOTT RD LOT 27

Repair—Renewal—New Service UPGRADE


Date	Material	Amount	Total	Date	Amount
13/99	99' 1" COPPER 1 3/4 X 1" UNION 1 1" UNION BUFF-LO BOX			10/18/58	16' 3/4 COPPER 3/4 CORP 3/4 CURB STEP

DATE _____

TOWN OF LEXINGTON — BOARD OF PUBLIC WORKS

WATER DIVISION

Sketch of Service Here

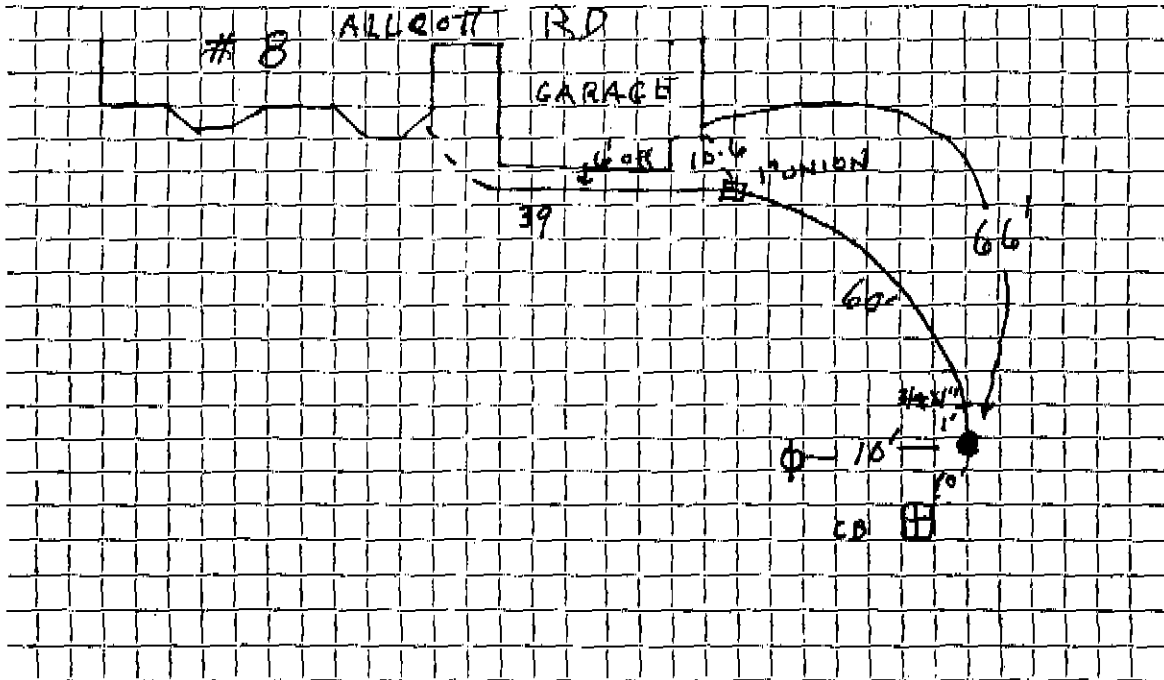

Connection made in Street. Work completed

marks:

.....

.....