

WATER SERVICE RECORD

3497

Name Moore Realty Trust

Service No. 266

Address 9 Alcott Road

Location Lot #20

Repair - Renewal - New Service

Comm 3-16-59

Date	Material	Amount	Total	Date		Amount
1/25/58	Labor	9 66		11-24-58	Deposit	30 00
	10% overhead	97	10 63	3-24-59	Tail	30 19
	110' - 3/4" Copper tubing @ .37		40 70			40 19
	1 - 3/4" Cx 1/2 I.W.H. Stop & Waste		5 84		NON CHARGE	
	1 3/4" C. Union (3 part)		2 27	10-18-58	Labor	13.50
	1 hr. Trucking		75			
			60 19		48' 3/4" Copper tubing @.37	17.76
					1 3/4" C Corp Cock	4.65
					1 3/4" C Curb Cock	6.05
					1 Box & Rod	5.00
						47.02
					1 - 1/2 Straight tailpiece	50
					1 - 1/2 Offset tailpiece	50
						48 02


By 3-16-59

30.17

DATE 3/8/59

TOWN OF LEXINGTON — BOARD OF PUBLIC WORKS
WATER DIVISION

Sketch of Service Here

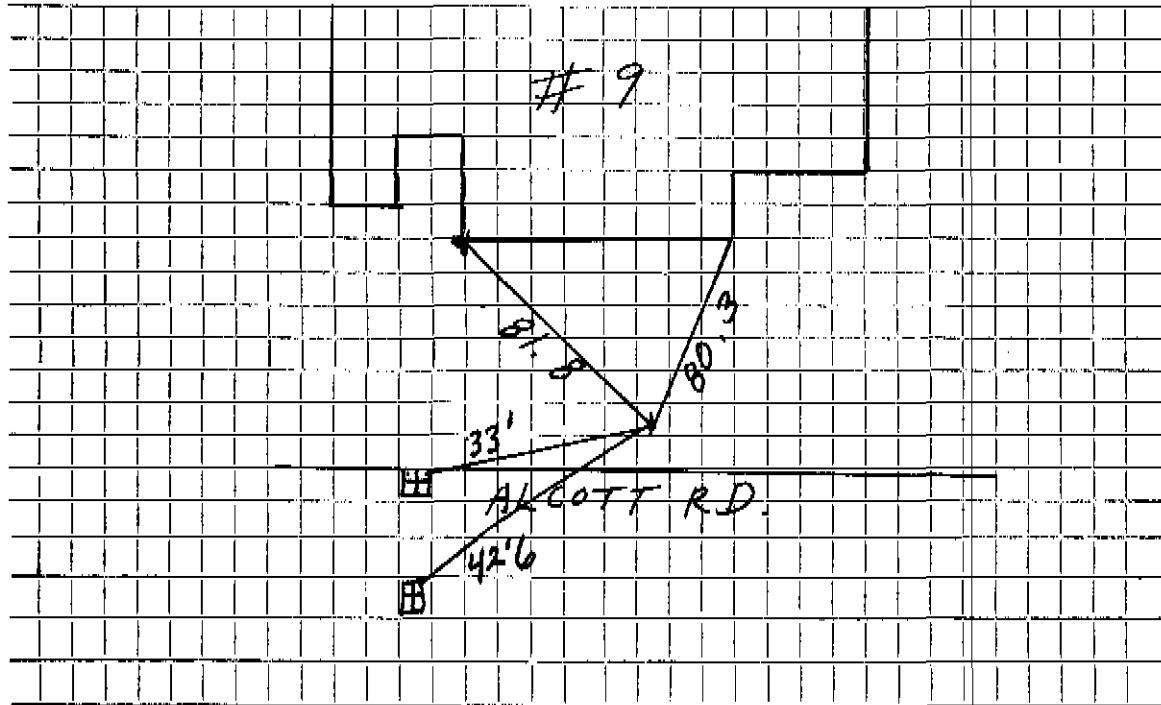


Connection made in ALCOTT RD. Street. Work completed

Remarks:

DATE 3/8/59

TOWN OF LEXINGTON — BOARD OF PUBLIC WORKS
WATER DIVISION

Sketch of Service Here

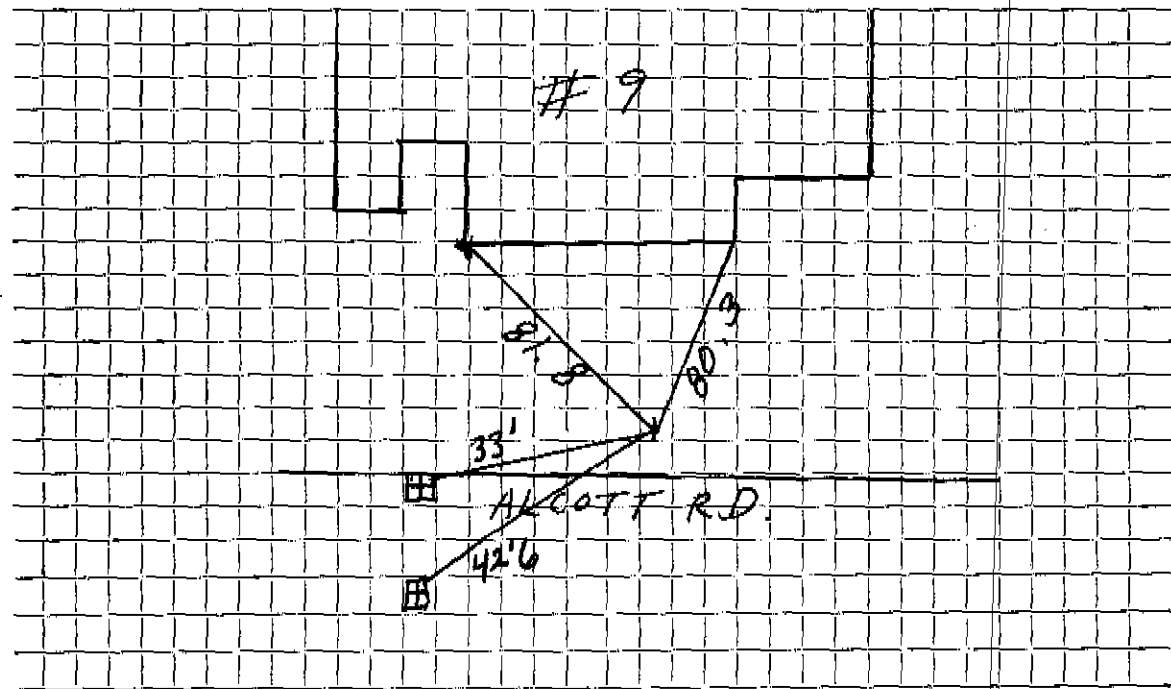

Connection made in ... ALCOTT RD. ... Street. Work completed

Remarks: