

## WATER SERVICE RECORD

Name Ted Freeman

Service No. 71

Address 11 Allen St. Lot #5

Location STA 7+10

Repair—Renewal—New Service  Dave Eagle #2458


Comm 3-29-58

Date	Material	Amount	Total	Date	Amount	
3-27-74	70' - 1" Copper			4-5-73	Repair	140.00
1-28-73	Labor	36.58				
12-7-73	"	18.35	54.93			
	10% C.H.	5.49	60.42		OUTSIDE	
16'	1" Copper tubing		21.60	8-21-59	Labor	27.30
1	1" Corp		13.79	30'	3/4" Copper tubing @.38	11.40
1	1" Curb Cock		14.60	1	3/4" C Corp Cock	4.67
1	Box & Rod		7.34	1	3/4" C Curb Cock	6.07
2	hrs. Town Shovel @6.50		13.00	1	Box & Rod	5.00
2	hrs. Trucking @3.00		6.00	1	hr. Trucking	75
1	ton Cold Patch		8.25			55.19
1	ton Hot Top		8.00			
1	hr. Roller @2.00		2.00			
1	hr. Compressor		5.00			
			160.00			

DATE \_\_\_\_\_

TOWN OF LEXINGTON — BOARD OF PUBLIC WORKS  
WATER DIVISION

Sketch of Service Here

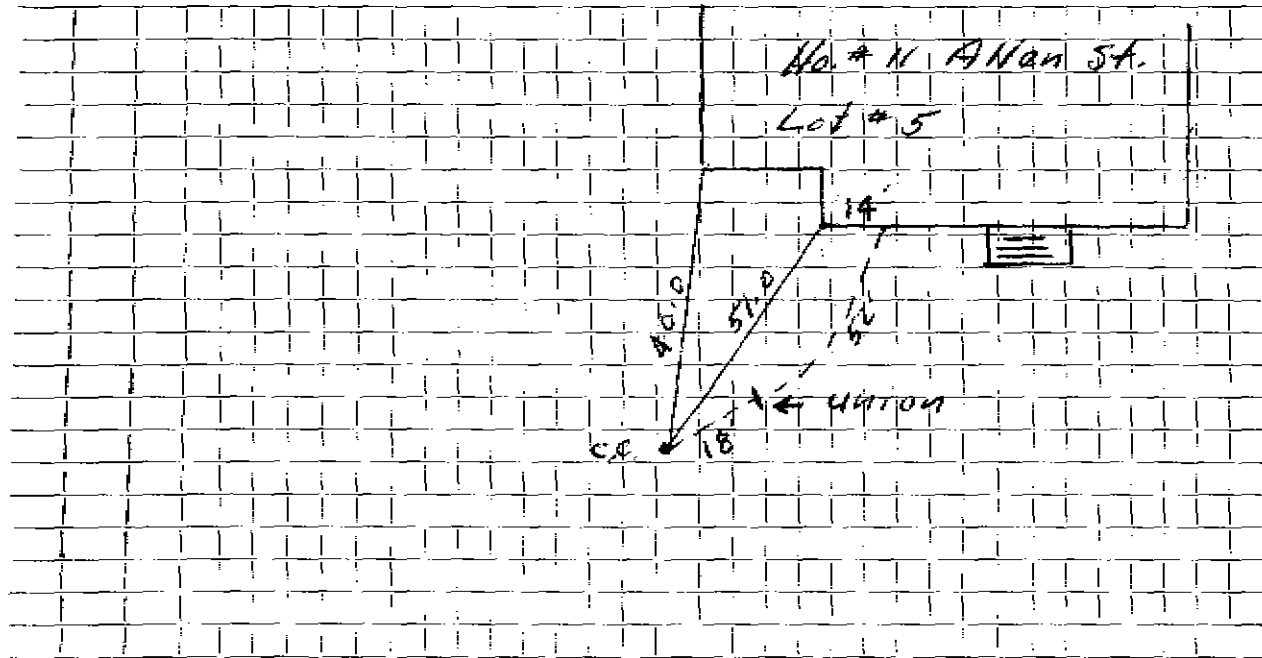

Connection made in ..... Street. Work completed .....

Remarks: .....

.....

.....